


1 LOCATION OF WATER WELL: Fraction SE 1/4 NE 1/4 NW 1/4 Section Number 27 Township Number T 26 S Range Number R 3 E/W  
 County: Butler

Distance and direction from nearest town or city street address of well if located within city?

4 N 5 E of Towanda

2 WATER WELL OWNER: John Standfast 67017  
 RR#, St. Address, Box #: Box 123-21 Benton Kan Board of Agriculture, Division of Water Resources  
 City, State, ZIP Code: Benton Kan Application Number:

3 LOCATE WELL'S LOCATION WITH AN "X" IN SECTION BOX: 4 DEPTH OF COMPLETED WELL: 105 ft. ELEVATION: 105 ft.

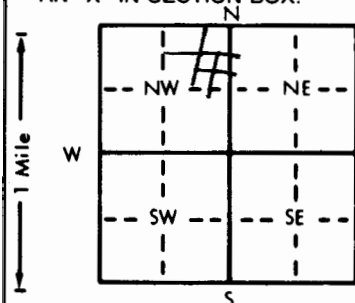

 WELL'S STATIC WATER LEVEL 40 ft. below land surface measured on mo/day/yr

Pump test data: Well water was 30 ft. after 15 hours pumping 105 gpm



WELL WATER TO BE USED AS: 5 Public water supply 8 Air conditioning 11 Injection well

1 Domestic 3 Feedlot 6 Oil field water supply 9 Dewatering 12 Other (Specify below)

2 Irrigation 4 Industrial 7 Lawn and garden only 10 Monitoring well

Was a chemical/bacteriological sample submitted to Department? Yes X No X; If yes, mo/day/yr sample was submitted

Water Well Disinfected? Yes X No X

5 TYPE OF BLANK CASING USED: 5 Wrought iron 8 Concrete tile CASING JOINTS: Glued X Clamped X

1 Steel 3 RMP (SR) 6 Asbestos-Cement 9 Other (specify below) Welded X

2 PVC 4 ABS 7 Fiberglass Threaded X


Casing height above land surface 18 in., weight 200 lbs./ft. Wall thickness or gauge No. 12/14

TYPE OF SCREEN OR PERFORATION MATERIAL: 7 PVC 10 Asbestos-cement

1 Steel 3 Stainless steel 5 Fiberglass 8 RMP (SR) 11 Other (specify)

2 Brass 4 Galvanized steel 6 Concrete tile 9 ABS 12 None used (open hole)

SCREEN OR PERFORATION OPENINGS ARE: 5 Gauzed wrapped 8 Saw cut 11 None (open hole)

1 Continuous slot 3 Mill slot 6 Wire wrapped 9 Drilled holes

2 Louvered shutter 4 Key punched 7 Torch cut 10 Other (specify)





6 GROUT MATERIAL: 1 Neat cement 2 Cement grout 3 Bentonite 4 Other


What is the nearest source of possible contamination: 10 Livestock pens 14 Abandoned water well

1 Septic tank 4 Lateral lines 7 Pit privy 11 Fuel storage 15 Oil well/Gas well

2 Sewer lines 5 Cess pool 8 Sewage lagoon 12 Fertilizer storage 16 Other (specify below)

3 Watertight sewer lines 6 Seepage pit 9 Feedyard 13 Insecticide storage

Direction from well? S How many feet? 200

FROM TO LITHOLOGIC LOG FROM TO PLUGGING INTERVALS

0 5 Soil 0 5

5 14 Clay 5 14

14 30 Clay + Shale 14 30

30 105 Shale + Lime 30 105

7 CONTRACTOR'S OR LANDOWNER'S CERTIFICATION: This water well was (1) constructed, (2) reconstructed, or (3) plugged under my jurisdiction and was

completed on (mo/day/year) 5/11/89 and this record is true to the best of my knowledge and belief. Kansas

Water Well Contractor's License No. 1251 This Water Well Record was completed on (mo/day/yr) 6/28/89

under the business name of Winter Well by (signature) Charles W. Winter