


1 LOCATION OF WATER WELL: County: Butler Fraction: NE 1/4 SW 1/4 NE 1/4 Section Number: 32 Township Number: T 26 S Range Number: R 3 E

Distance and direction from nearest town or city street address of well if located within city?

3 N of Andover

2 WATER WELL OWNER: Richard Stowell Wichita Kan
 RR#, St. Address, Box #: 8224 E Douglas 67206 Board of Agriculture, Division of Water Resources
 City, State, ZIP Code: 8224 E Douglas 67206 Application Number:

3 LOCATE WELL'S LOCATION WITH AN "X" IN SECTION BOX:

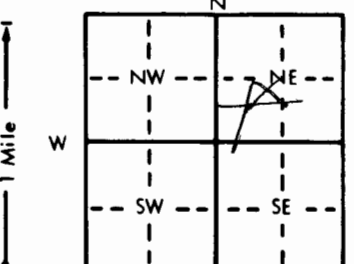

4 DEPTH OF COMPLETED WELL: 105 ft. ELEVATION: 105 ft.
 Depth(s) Groundwater Encountered: 1 ft. 2. 80 ft. 3. 80 ft.
 WELL'S STATIC WATER LEVEL: 35 ft. below land surface measured on mo/day/yr
 Pump test data: Well water was 25 gpm; Well water was 8 1/2 in. to 8 1/2 ft. after 8 hours pumping 8 gpm
 Est. Yield 25 gpm; Well water was 8 1/2 in. to 8 1/2 ft. after 8 hours pumping 8 gpm
 Bore Hole Diameter: 8 1/2 in. to 8 1/2 ft. and 8 1/2 in. to 8 1/2 ft.
 WELL WATER TO BE USED AS: 5 Public water supply 8 Air conditioning 11 Injection well
 1 Domestic 3 Feedlot 6 Oil field water supply 9 Dewatering 12 Other (Specify below)
 2 Irrigation 4 Industrial 7 Lawn and garden only 10 Observation well
 Was a chemical/bacteriological sample submitted to Department? Yes X No X If yes, mo/day/yr sample was submitted 8
 Water Well Disinfected? Yes X No X

5 TYPE OF BLANK CASING USED: 1 Steel 3 RMP (SR) 5 Wrought iron 8 Concrete tile CASING JOINTS: Glued X Clamped X
 2 PVC 4 ABS 6 Asbestos-Cement 9 Other (specify below) Welded X
 7 Fiberglass Threaded X
 Blank casing diameter 3 in. to 60 ft. Dia 200 in. to 200 ft. Dia 1214 in. to 1214 ft.
 Casing height above land surface 18 in., weight 200 lbs./ft. Wall thickness or gauge No. 1214
 TYPE OF SCREEN OR PERFORATION MATERIAL: 1 Steel 3 Stainless steel 5 Fiberglass 7 PVC 10 Asbestos-cement
 2 Brass 4 Galvanized steel 6 Concrete tile 8 RMP (SR) 11 Other (specify) 8
 9 ABS 12 None used (open hole)
 SCREEN OR PERFORATION OPENINGS ARE: 5 Gauzed wrapped 8 Saw cut 11 None (open hole)
 1 Continuous slot 3 Mill slot 6 Wire wrapped 9 Drilled holes
 2 Louvered shutter 4 Key punched 7 Torch cut 10 Other (specify) 8
 SCREEN-PERFORATED INTERVALS: From 60 ft. to 105 ft. From 60 ft. to 105 ft.
 GRAVEL PACK INTERVALS: From 40 ft. to 105 ft. From 40 ft. to 105 ft.

6 GROUT MATERIAL: 1 Neat cement 2 Cement grout 3 Bentonite 4 Other 3
 Grout Intervals: From 3 ft. to 13 ft. From 3 ft. to 13 ft.
 What is the nearest source of possible contamination: 1 Septic tank 4 Lateral lines 7 Pit privy 10 Livestock pens 14 Abandoned water well
 2 Sewer lines 5 Cess pool 8 Sewage lagoon 11 Fuel storage 15 Oil well/Gas well
 3 Watertight sewer lines 6 Seepage pit 9 Feedyard 12 Fertilizer storage 16 Other (specify below)
 13 Insecticide storage
 Direction from well? N E How many feet? 300

FROM	TO	LITHOLOGIC LOG	FROM	TO	LITHOLOGIC LOG
0	40	Soil			
40	10	Rock			
10	15	Clay			
15	30	Shale			
30	50	Shale			
50	105	Lime			

7 CONTRACTOR'S OR LANDOWNER'S CERTIFICATION: This water well was (1) constructed, (2) reconstructed, or (3) plugged under my jurisdiction and was completed on (mo/day/year) 2/3/84 and this record is true to the best of my knowledge and belief. Kansas Water Well Contractor's License No. 251184 This Water Well Record was completed on (mo/day/yr) 2/30/84 under the business name of Winter Well Drill by (signature) Charles Winter
 INSTRUCTIONS: Use typewriter or ball point pen, PLEASE PRESS FIRMLY and PRINT clearly. Please fill in blanks, underline or circle the correct answers. Send top three copies to Kansas Department of Health and Environment, Division of Environment, Environmental Geology Section, Topeka, KS 66620. Send one to WATER WELL OWNER and retain one for your records.