

1 LOCATION OF WATER WELL:

Fraction

County: *Bat*herSE $\frac{1}{4}$ SW $\frac{1}{4}$ SE $\frac{1}{4}$

Section Number

Township Number

Range Number

T 26 S

R 30 E/W

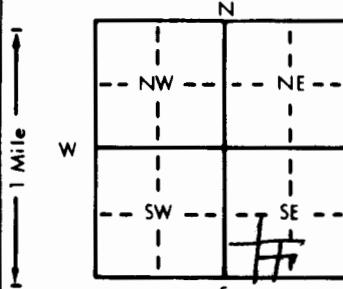
Distance and direction from nearest town or city street address of well if located within city?

2 WATER WELL OWNER: *Charles Karo Wichita Kan 67220*RR#, St. Address, Box #: *2400 N Woodlawn* Board of Agriculture, Division of Water Resources

City, State, ZIP Code

Application Number:

3 LOCATE WELL'S LOCATION WITH AN "X" IN SECTION BOX:

4 DEPTH OF COMPLETED WELL: *745* ft. ELEVATION:Depth(s) Groundwater Encountered *1. 15* ft. 2. ft. 3. ft.WELL'S STATIC WATER LEVEL *25* ft. below land surface measured on mo/day/yr

Pump test data: Well water was ft. after hours pumping gpm

Est. Yield *15* gpm Well water was ft. after hours pumping gpmBore Hole Diameter *8* in. to ft., and in. to ft.

WELL WATER TO BE USED AS: 5 Public water supply 8 Air conditioning 11 Injection well

1 Domestic 3 Feedlot 6 Oil field water supply 9 Dewatering 12 Other (Specify below)

2 Irrigation 4 Industrial *lawn and garden only* 10 Monitoring wellWas a chemical/bacteriological sample submitted to Department? Yes No If yes, mo/day/yr sample was submittedWater Well Disinfected? Yes No

5 TYPE OF BLANK CASING USED:

1 Steel 3 RMP (SR)

② PVC 4 ABS

Blank casing diameter *5* in. to *50* ft., Dia. in. to ft., Dia. in. to ft.Casing height above land surface *18* in., weight *160* lbs./ft. Wall thickness or gauge No. *1214*

TYPE OF SCREEN OR PERFORATION MATERIAL:

1 Steel 3 Stainless steel

2 Brass 4 Galvanized steel

5 Fiberglass 8 RMP (SR)

6 Concrete tile 9 ABS

5 Gauzed wrapped 8 Saw cut 11 None (open hole)

6 Wire wrapped 9 Drilled holes

7 Torch cut 10 Other (specify)

SCREEN OR PERFORATION OPENINGS ARE:

1 Continuous slot 3 Mill slot

2 Louvered shutter 4 Key punched

SCREEN-PERFORATED INTERVALS: From *50* ft. to *145* ft., From ft. to ft., From ft. to ft.

From ft. to ft., From ft. to ft., From ft. to ft.

GRAVEL PACK INTERVALS: From ft. to ft., From ft. to ft., From ft. to ft.

From ft. to ft., From ft. to ft., From ft. to ft.

6 GROUT MATERIAL: 1 Neat cement 2 Cement grout 3 Bentonite 4 Other

Grout Intervals: From *0* ft. to *20* ft., From ft. to ft., From ft. to ft., From ft. to ft.

What is the nearest source of possible contamination:

1 Septic tank 4 Lateral lines 7 Pit privy 11 Fuel storage 14 Abandoned water well

2 Sewer lines 5 Cess pool 8 Sewage lagoon 12 Fertilizer storage 15 Oil well/Gas well

3 Watertight sewer lines 6 Seepage pit 9 Feedyard 13 Insecticide storage 16 Other (specify below)

Direction from well? *SE* How many feet? *150*

FROM TO LITHOLOGIC LOG FROM TO PLUGGING INTERVALS

*0 4 15 185 SE Soil Clay Shale Lime*7 CONTRACTOR'S OR LANDOWNER'S CERTIFICATION: This water well was constructed, reconstructed, or plugged under my jurisdiction and was completed on (mo/day/year) *3/9/91* and this record is true to the best of my knowledge and belief. KansasWater Well Contractor's License No. *1251* This Water Well Record was completed on (mo/day/year) *3/9/91*under the business name of *Winter Well Drill* by (signature) *Charles Winter*

INSTRUCTIONS: Use typewriter or ball point pen. PLEASE PRESS FIRMLY and PRINT clearly. Please fill in blanks, underline or circle the correct answers. Send top three copies to Kansas Department of Health and Environment, Bureau of Water, Topeka, Kansas 66620-7320. Telephone: 913-296-5545. Send one to WATER WELL OWNER and retain one for your records.