

WATER WELL RECORD Form WWC-5 KSA 82a-1212

1 LOCATION OF WATER WELL		Fraction SW 1/4 SW 1/4 SW 1/4			Section Number 33	Township Number T 26 S	Range Number R 3 EW
--------------------------	--	-------------------------------	--	--	-------------------	------------------------	---------------------

County: BUTLER Distance and direction from nearest town or city? 1 1/2 E. of Andover Rd. on 29th N.--North side of Street address of well if located within city? Rd. Andover, Kansas

2 WATER WELL OWNER: Arber Homes
RR#, St. Address, Box # : 116 Aarron
City, State, ZIP Code : Andover, Kansas

Board of Agriculture, Division of Water Resources
Application Number:

3 DEPTH OF COMPLETED WELL 110 ft. Bore Hole Diameter 11 in. to ft., and in. to ft.

Well Water to be used as: 5 Public water supply 8 Air conditioning 11 Injection well
1 Domestic 3 Feedlot 6 Oil field water supply 9 Dewatering 12 Other (Specify below)
2 Irrigation 4 Industrial 7 Lawn and garden only 10 Observation well

Well's static water level 20 ft. below land surface measured on 6 month 29 day 1979 year

Pump Test Data: Well water was ft. after hours pumping gpm
Est. Yield gpm: Well water was ft. after hours pumping gpm

4 TYPE OF BLANK CASING USED: 5 Wrought iron 8 Concrete tile Casing Joints: Glued Clamped
1 Steel =3 BMP (SR) 6 Asbestos-Cement 9 Other (specify below) Welded
2 PVC 4 ABS 7 Fiberglass Threaded

Blank casing dia 5 in. to 20 ft., Dia in. to ft., Dia in. to ft.

Casing height above land surface 12 in., weight lbs./ft. Wall thickness or gauge No. 200

TYPE OF SCREEN OR PERFORATION MATERIAL: 7 PVC 10 Asbestos-cement

1 Steel 3 Stainless steel 5 Fiberglass 8 RMP (SR) 11 Other (specify)
2 Brass 4 Galvanized steel 6 Concrete tile 9 ABS 12 None used (open hole)

Screen or Perforation Openings Are: 5 Gauzed wrapped 8 Saw cut .06 11 None (open hole)
1 Continuous slot 3 Mill slot 6 Wire wrapped 9 Drilled holes
2 Louvered shutter 4 Key punched 7 Torch cut 10 Other (specify)

Screen-Perforation Dia. 5 in. to 110 ft., Dia in. to ft., Dia in. to ft.

Screen-Perforated Intervals: From .20 ft. to 110 ft., From ft. to ft., From ft. to ft.

Gravel Pack Intervals: From 14 ft. to 110 ft., From ft. to ft., From ft. to ft.

From ft. to ft., From ft. to ft.

5 GROUT MATERIAL: 1 Neat cement 2 Cement grout 3 Bentonite 4 Other

Grouted Intervals: From 40" to 14 ft., From ft. to ft., From ft. to ft., From ft. to ft.

What is the nearest source of possible contamination: Septic System not installed 10 Fuel storage 14 Abandoned water well

1 Septic tank 4 Cess pool at this time 7 Sewage lagoon 11 Fertilizer storage 15 Oil well/Gas well

2 Sewer lines 5 Seepage pit 8 Feed yard 12 Insecticide storage 16 Other (specify below)

3 Lateral lines 6 Pit privy 9 Livestock pens 13 Watertight sewer lines No apparent source

Direction from well How many feet ? Water Well Disinfected? Yes No

Was a chemical/bacteriological sample submitted to Department? Yes No If yes, date sample

was submitted month day year: Pump Installed? Yes No

If Yes: Pump Manufacturer's name Model No. HP Volts

Depth of Pump Intake ft. Pumps Capacity rated at gal/min.

Type of pump: 1 Submersible 2 Turbine 3 Jet 4 Centrifugal 5 Reciprocating 6 Other

6 CONTRACTOR'S OR LANDOWNER'S CERTIFICATION: This water well was (1) constructed, (2) reconstructed, or (3) plugged under my jurisdiction and was


completed on 6 month 29 day 1979 year

and this record is true to the best of my knowledge and belief. Kansas Water Well Contractor's License No. 236

This Water Well Record was completed on 7 month 26 day 1979 year under the business

name of Harp Well & Pump Service, Inc. by (signature) M. Arnold

7 LOCATE WELL'S LOCATION WITH AN "X" IN SECTION BOX:

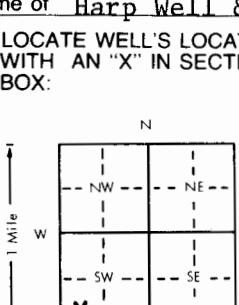

ELEVATION: Slope

Depth(s) Groundwater Encountered 1 ft. 2 ft. 3 ft. 4 ft. (Use a second sheet if needed)

INSTRUCTIONS: Use typewriter or ball point pen, please press firmly and PRINT clearly. Please fill in blanks, underline or circle the correct answers. Send top three copies to Kansas Department of Health and Environment, Division of Environment, Water Well Contractors, Topeka, KS 66620. Send one to WATER WELL OWNER and retain one for your records.