

1 LOCATION OF WATER WELL:

Fraction

SW 1/4 NE 1/4 SW 1/4

Section Number

Township Number

Range Number

County: Butler

T 26 S

R 3 EW

Distance and direction from nearest town or city street address of well if located within city?

1 mi North and 2 1/2 mi. East of Andover

2 WATER WELL OWNER:

Rodney Crouch

RR#, St. Address, Box #:

1315 Tavern

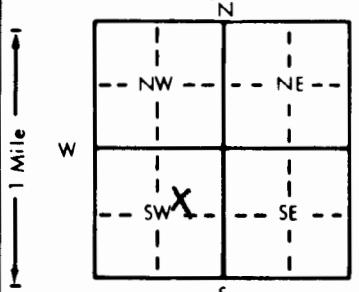
City, State, ZIP Code

Andover, KS 67002

Board of Agriculture, Division of Water Resources

Application Number:

3 LOCATE WELL'S LOCATION WITH AN "X" IN SECTION BOX:

4 DEPTH OF COMPLETED WELL: 100

ft. ELEVATION: \_\_\_\_\_

Depth(s) Groundwater Encountered 100 ft. 2. \_\_\_\_\_ ft. 3. \_\_\_\_\_ ft.WELL'S STATIC WATER LEVEL 30 ft. below land surface measured on mo/day/yr 5/2/92

Pump test data: Well water was \_\_\_\_\_ ft. after \_\_\_\_\_ hours pumping \_\_\_\_\_ gpm

Est. Yield 40 gpm: Well water was \_\_\_\_\_ ft. after \_\_\_\_\_ hours pumping \_\_\_\_\_ gpmBore Hole Diameter 10 in. to \_\_\_\_\_ ft., and \_\_\_\_\_ in. to \_\_\_\_\_ ft.

WELL WATER TO BE USED AS: 5 Public water supply 8 Air conditioning 11 Injection well

1 Domestic 3 Feedlot 6 Oil field water supply 9 Dewatering 12 Other (Specify below)

2 Irrigation 4 Industrial 7 Lawn and garden only 10 Monitoring well

Was a chemical/bacteriological sample submitted to Department? Yes  No  If yes, mo/day/yr sample was submittedWater Well Disinfected? Yes  No 

5 TYPE OF BLANK CASING USED:

1 Steel PVC 3 RMP (SR) 4 ABS

5 Wrought iron 8 Concrete tile Casing joints: Glued \_\_\_\_\_ Clamped \_\_\_\_\_

6 Asbestos-Cement Welded \_\_\_\_\_

7 Fiberglass Threaded \_\_\_\_\_

Blank casing diameter 5 in. to \_\_\_\_\_ ft., Dia. \_\_\_\_\_ in. to \_\_\_\_\_ ft.Casing height above land surface 12 in., weight 160 lbs./ft. Wall thickness or gauge No. \_\_\_\_\_

TYPE OF SCREEN OR PERFORATION MATERIAL:

1 Steel 3 Stainless steel 5 Fiberglass 8 RMP (SR) 10 Asbestos-cement  
2 Brass 4 Galvanized steel 6 Concrete tile 9 ABS 11 Other (specify) \_\_\_\_\_  
1 Continuous slot 3 Mill slot 5 Gauzed wrapped 8 Saw cut 11 None (open hole)  
2 Louvered shutter 4 Key punched 6 Wire wrapped 9 Drilled holes  
7 Torch cut 10 Other (specify) \_\_\_\_\_

SCREEN OR PERFORATION OPENINGS ARE: \_\_\_\_\_

SCREEN-PERFORATED INTERVALS: From 20 ft. to 100 ft. From \_\_\_\_\_ ft. to \_\_\_\_\_ ft.GRAVEL PACK INTERVALS: From 20 ft. to 100 ft. From \_\_\_\_\_ ft. to \_\_\_\_\_ ft.

From \_\_\_\_\_ ft. to \_\_\_\_\_ ft. From \_\_\_\_\_ ft. to \_\_\_\_\_ ft.

6 GROUT MATERIAL: 1 Neat cement 2 Cement grout 3 Bentonite 4 Other \_\_\_\_\_Grout Intervals: From 3 ft. to 20 ft., From \_\_\_\_\_ ft. to \_\_\_\_\_ ft., From \_\_\_\_\_ ft. to \_\_\_\_\_ ft.

What is the nearest source of possible contamination: \_\_\_\_\_

1 Septic tank 4 Lateral lines 7 Pit privy  
2 Sewer lines 5 Cess pool 8 Sewage lagoon  
3 Watertight sewer lines 6 Seepage pit 9 Feedyard

10 Livestock pens 14 Abandoned water well

11 Fuel storage 15 Oil well/Gas well

12 Fertilizer storage 16 Other (specify below)

13 Insecticide storage

How many feet? 100+Direction from well? down slope

FROM TO LITHOLOGIC LOG FROM TO PLUGGING INTERVALS

FROM	TO	LITHOLOGIC LOG	FROM	TO	PLUGGING INTERVALS
0	3	earth			
3	16	brown & red clay			
16	32	shale			
32	78	yellow clay			
78	95	red bed			
95	110	sandy lime			

&lt;/div