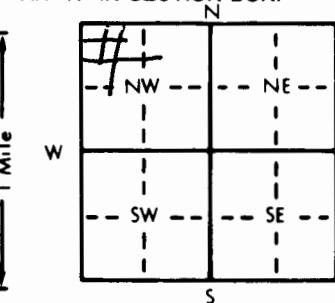


WATER WELL RECORD Form WWC-5 KSA 82a-1212

1 LOCATION OF WATER WELL: County: Butler	Fraction: NW 1/4 NW 1/4	Section Number: 38	Township Number: T 26 S	Range Number: R 3 NW
Distance and direction from nearest town or city street address of well if located within city? 4 W 5 N of Augusta				
2 WATER WELL OWNER: RR#, St. Address, Box # : Tom Pjacezo Rt Box 151 Augusta Kan	67010 Board of Agriculture, Division of Water Resources Application Number:			
3 LOCATE WELL'S LOCATION WITH AN "X" IN SECTION BOX: 	4 DEPTH OF COMPLETED WELL: 145 ft. ELEVATION: 50 95 Depth(s) Groundwater Encountered ft. ft. 2 ft. 3 ft. WELL'S STATIC WATER LEVEL ft. below land surface measured on mo/day/yr Pump test data: Well water was ft. after hours pumping gpm Est. Yield 35 gpm: Well water was ft. after hours pumping gpm Bore Hole Diameter 8 1/2 in. to ft. and in. to ft. WELL WATER TO BE USED AS: 5 Public water supply 8 Air conditioning 11 Injection well 1 Domestic 3 Feedlot 6 Oil field water supply 9 Dewatering 12 Other (Specify below) 2 Irrigation 4 Industrial 7 Lawn and garden only 10 Monitoring well Was a chemical/bacteriological sample submitted to Department? Yes <input checked="" type="checkbox"/> No <input type="checkbox"/> If yes, mo/day/yr sample was submitted Water Well Disinfected? Yes <input checked="" type="checkbox"/> No <input type="checkbox"/>			
5 TYPE OF BLANK CASING USED: 1 Steel 3 RMP (SR) 2 PVC 4 ABS	5 Wrought iron 8 Concrete tile 6 Asbestos-Cement 9 Other (specify below) 7 Fiberglass	CASING JOINTS: Glued <input checked="" type="checkbox"/> Clamped <input type="checkbox"/> Welded <input type="checkbox"/> Threaded <input type="checkbox"/>		
Blank casing diameter 5 in. to 70 ft., Dia in. to ft., Dia in. to ft. Casing height above land surface 18 in., weight lbs./ft. Wall thickness or gauge No. 2 1/4				
TYPE OF SCREEN OR PERFORATION MATERIAL: 1 Steel 3 Stainless steel 5 Fiberglass 8 RMP (SR) 2 Brass 4 Galvanized steel 6 Concrete tile 9 ABS	10 Asbestos-cement 11 Other (specify) 12 None used (open hole)			
SCREEN OR PERFORATION OPENINGS ARE: 1 Continuous slot 3 Mill slot 5 Gauzed wrapped 2 Louvered shutter 4 Key punched 6 Wire wrapped 7 Torch cut	8 Saw cut 11 None (open hole) 9 Drilled holes 10 Other (specify)			
SCREEN-PERFORATED INTERVALS: From 70 ft. to 145 ft., From ft. to ft., From ft. to ft. From ft. to ft., From ft. to ft., From ft. to ft.				
GRAVEL PACK INTERVALS: From ft. to ft., From ft. to ft., From ft. to ft., From ft. to ft.				
6 GROUT MATERIAL: 1 Neat cement 2 Cement grout 3 Bentonite 4 Other Grout Intervals: From 0 ft. to 20 ft., From ft. to ft., From ft. to ft., From ft. to ft.	10 Livestock pens 14 Abandoned water well 11 Fuel storage 15 Oil well/Gas well 12 Fertilizer storage 16 Other (specify below) 13 Insecticide storage			
What is the nearest source of possible contamination: 1 Septic tank 4 Lateral lines 7 Pit privy 2 Sewer lines 5 Cess pool 8 Sewage lagoon 3 Watertight sewer lines 6 Seepage pit 9 Feedyard	How many feet? 150			
Direction from well? S - E	PLUGGING INTERVALS			
FROM 0 TO 30 LITHOLOGIC LOG	FROM 30 TO 70	FROM 70 TO 12	FROM 12 TO 145	FROM 145 TO 50
Silt Clay Rock Shale & Limestone				
7 CONTRACTOR'S OR LANDOWNER'S CERTIFICATION: This water well was 1 constructed, 2 reconstructed, or 3 plugged under my jurisdiction and was completed on (mo/day/year) 11/19/91 and this record is true to the best of my knowledge and belief. Kansas Water Well Contractor's License No. 125 This Water Well Record was completed on (mo/day/yr) 11/19/91 by (signature) Charles Winter				