

WATER WELL PLUGGING RECORD Form WWC-5P

KSA 82a-1212

ID NO.

RW-33

1 LOCATION OF WATER WELL: Fraction ¼ SW ¼ NE ¼ SW ¼ Section Number 5 Township Number T 26 S Range Number 3 E W
 County: Butler


Street/Rural Address of Well Location; if unknown, distance & direction from nearest town or intersection: If at owner's address, check here Approximately one half mile east and south of NW Butler Road and SW Parallel Street, north of Benton, KS

Global Positioning Systems (GPS) information:
 Latitude: 37.81650 (in decimal degrees)
 Longitude: -97.13074 (in decimal degrees)
 Elevation: _____
 Horizontal Datum: WGS84, NAD83, NAD27
 Collection Method: _____

2 WATER WELL OWNER: El Paso Merchant Energy
 RR#, St. Address, Box #: 2 N. Nevada Ave.
 City, State ZIP Code: Colorado Springs, CO80903

GPS unit (Make/Model: Garmin etrek)
 Digital Map/Photo, Topographic Map, Land Survey
 Est. Accuracy: < 3 m, 3-5 m, 5-15 m, > 15 m

3 MARK WELL'S LOCATION WITH AN "X" IN SECTION BOX:

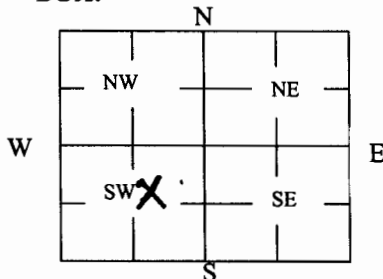

4 DEPTH OF WELL 11 ft.

WELL'S STATIC WATER LEVEL 1.93 ft

WELL WAS USED AS:

- Domestic
- Public Water Supply
- Dewatering
- Irrigation
- Oil Field Water Supply
- Monitoring
- Feedlot
- Domestic (Lawn & Garden)
- Injection Well
- Industrial
- Air Conditioning
- Other _____

Was a chemical/bacteriological sample submitted to Department? Yes No

5 TYPE OF BLANK CASING USED:

- Steel
- RMP (SR)
- Wrought
- Fiberglass
- Other (Specify below) _____
- PVC
- ABS
- Asbestos-Cement
- Concrete Tile

Blank casing diameter 4 in. Was casing pulled? Yes No If yes, how much all
 Casing height above or below land surface 12 in.

6 GROUT PLUG MATERIAL: Neat cement Cement grout Bentonite Other Top Soil

Grout Plug Intervals: From 0 ft. to 3 ft., From 3 ft. to 11 ft., From — ft. to — ft.

What is the nearest source of possible contamination:

- Septic tank
- Seepage pit
- Fuel storage
- Other (specify below) _____
- Sewer lines
- Pit privy
- Fertilizer storage
- unknown
- Watertight sewer lines
- Sewage lagoon
- Insecticide storage
- Lateral lines
- Feedyard
- Abandoned water well
- Direction from well? unknown
- Cess pool
- Livestock pens
- Oil well/Gas well
- How many feet? unknown

FROM	TO	PLUGGING MATERIALS	FROM	TO	PLUGGING MATERIALS
0	3	Top Soil			
3	11	Bentonite			

7 CONTRACTOR'S OR LANDOWNER'S CERTIFICATION: This water well was plugged under my jurisdiction and was completed on (mo/day/year) 1-29-2019 and this record is true to the best of my knowledge and belief. Kansas Water Well Contractor's License No. 710. This Water Well Record was completed on (mo/day/year) 2-4-2019 under the business name of Below Ground Surface, Inc. by (signature) Craig K. Hearn

Send one white copy to Kansas Department of Health & Environment, Geology Section, 1000 SW Jackson Street, Ste. 420, Topeka, KS 66612-1367. Send one copy to WATER WELL OWNER and retain one for your records.
 Visit us at <http://www.kdheks.gov/waterwell/index.html> Telephone 785-296-5524.