

1 LOCATION OF WATER WELL:

Fraction

1/4

NE 1/4

SE 1/4

1/4

Section Number

Township Number

Range Number

T 26 S

R 30 E

County: Butler

Distance and direction from nearest town or city street address of well if located within city?

3-West 3 N of Tawanda

2 WATER WELL OWNER:

Allen Young Tawanda Kay 69144

Board of Agriculture, Division of Water Resources


RR#, St. Address, Box #:

1995 W. Santa Fe Lake Rd

Application Number:

City, State, ZIP Code:

3 LOCATE WELL'S LOCATION WITH AN "X" IN SECTION BOX:

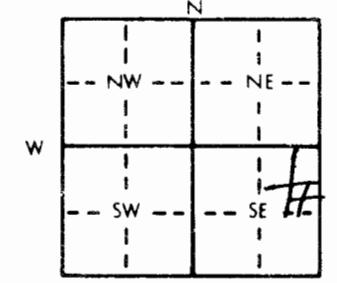

4 DEPTH OF COMPLETED WELL: 85 ft. ELEVATION:

Depth(s) Groundwater Encountered 1. 40 ft. 2. ft. 3. ft.

WELL'S STATIC WATER LEVEL: 30 ft. below land surface measured on mo/day/yr

Pump test data: Well water was ft. after hours pumping gpm

Est. Yield 35 gpm Well water was ft. after hours pumping gpm

Bore Hole Diameter 9 1/2 in. to ft., and in. to ft.

WELL WATER TO BE USED AS: 5 Public water supply 8 Air conditioning 11 Injection well

1 Domestic 3 Feedlot 6 Oil field water supply 9 Dewatering 12 Other (Specify below)

2 Irrigation 4 Industrial 7 Lawn and garden only 10 Monitoring well

Was a chemical/bacteriological sample submitted to Department? Yes No. If yes, mo/day/yr sample was submitted

Water Well Disinfected? Yes X No

5 TYPE OF BLANK CASING USED:

1 Steel 3 RMP (SR)
2 PVC 4 ABS

5 Wrought iron 8 Concrete tile

CASING JOINTS: Glued X Clamped

6 Asbestos-Cement

9 Other (specify below)

Welded

7 Fiberglass

Threaded

Blank casing diameter 5 in. to 30 ft., Dia.

in. to ft., Dia. in. to ft.

Casing height above land surface 18 in., weight

160 lbs./ft. Wall thickness or gauge No. 214

TYPE OF SCREEN OR PERFORATION MATERIAL:

1 Steel 3 Stainless steel 5 Fiberglass 8 RMP (SR)
2 Brass 4 Galvanized steel 6 Concrete tile 9 ABS

10 Asbestos-cement

SCREEN OR PERFORATION OPENINGS ARE:

1 Continuous slot 3 Mill slot 5 Gauzed wrapped 8 Wire wrapped
2 Louvered shutter 4 Key punched 6 Torch cut 7 Saw cut

11 None (open hole)

9 Drilled holes

10 Other (specify)

SCREEN-PERFORATED INTERVALS: From 30 ft. to 85 ft., From ft. to ft., From ft. to ft.

From ft. to ft., From ft