

## WATER WELL RECORD Form WWC-5 KSA 82a-1212

1 LOCATION OF WATER WELL:	Fraction County: Butler Distance and direction from nearest town or city street address of well if located within city?	Section Number SE $\frac{1}{4}$ NE $\frac{1}{4}$ NE $\frac{1}{4}$ 21	Township Number T 26 S	Range Number R 3 E/W
---------------------------	---	----------------------------------------------------------------------------	---------------------------	-------------------------

From the NE corner of Sec. 21,

891' S., 79' W.

2 WATER WELL OWNER: Richard Corkins


RR#, St. Address, Box #: 3193 Meadowark

City, State, ZIP Code: Benton, Ks. 67017

Board of Agriculture, Division of Water Resources

Application Number:

3 LOCATE WELL'S LOCATION WITH AN "X" IN SECTION BOX:

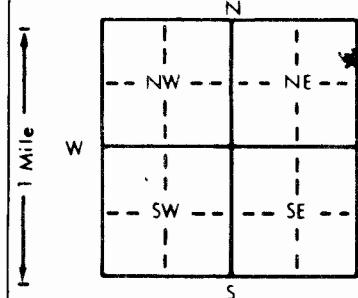

4 DEPTH OF COMPLETED WELL 160 ft. ELEVATION:

Depth(s) Groundwater Encountered 1. 73 ft. 2. ft. 3. ft.

WELL'S STATIC WATER LEVEL 50' 2" ft. below land surface measured on mo/day/yr 2/13/95

Pump test data: Well water was ft. after hours pumping gpm

Est. Yield 1. (open) Well water was ft. after hours pumping gpm

Bore Hole Diameter 1.0 in. to 1.60 ft. and in. to ft.

WELL WATER TO BE USED AS: 5 Public water supply 8 Air conditioning 11 Injection well

1 Domestic 3 Feedlot 6 Oil field water supply 9 Dewatering 12 Other (Specify below)

2 Irrigation 4 Industrial 7 Lawn and garden only 10 Monitoring well

Was a chemical/bacteriological sample submitted to Department? Yes. No. If yes, mo/day/yr sample was submitted

Water Well Disinfected? Yes No

5 TYPE OF BLANK CASING USED:

1 Steel	3 RMP (SR)	5 Wrought iron	8 Concrete tile	CASING JOINTS: Glued	Clamped
2 PVC	4 ABS	6 Asbestos-Cement	9 Other (specify below)	Welded	
		7 Fiberglass		Threaded	

Blank casing diameter 5 in. to ft. Dia. in. to ft. Dia. in. to ft.

Casing height above land surface in., weight lbs./ft. Wall thickness or gauge No.

TYPE OF SCREEN OR PERFORATION MATERIAL:

1 Steel	3 Stainless steel	5 Fiberglass	8 RMP (SR)	10 Asbestos-cement
2 Brass	4 Galvanized steel	6 Concrete tile	9 ABS	11 Other (specify)
		5 Gauzed wrapped	7 PVC	12 None used (open hole)

SCREEN OR PERFORATION OPENINGS ARE:

1 Continuous slot	3 Mill slot	6 Wire wrapped	9 Drilled holes
2 Louvered shutter	4 Key punched	7 Torch cut	10 Other (specify)

SCREEN-PERFORATED INTERVALS: From 50.6 ft. to 160 ft. From ft. to ft. From ft. to ft.

From ft. to ft. From ft. to ft. From ft. to ft.

GRAVEL PACK INTERVALS: From 145 ft. to 160 ft. From ft. to ft. From ft. to ft.

From ft. to ft. From ft. to ft. From ft. to ft.

6 GROUT MATERIAL: 1 Neat cement 2 Cement grout 3 Bentonite 4 Other

Grout Intervals: From 24 ft. to 10 (3) ft. From 10 ft. to 4 (1) ft. From 4 ft. to ft. From ft. to ft.

What is the nearest source of possible contamination:

1 Septic tank	4 Lateral lines	7 Pit privy	11 Fuel storage
2 Sewer lines	5 Cess pool	8 Sewage lagoon	12 Fertilizer storage
3 Watertight sewer lines	6 Seepage pit	9 Feedyard	13 Insecticide storage

Direction from well? SSW How many feet? +80

FROM	TO	LITHOLOGIC LOG	FROM	TO	PLUGGING INTERVALS
0.0	1.5	Top Soil			
1.5	14.0	Brownish weathered Shale			
14.0	21.0	Yellow gray clay			
21.0	39.0	Yellow gray shale			
39.0	40.0	Yellow gray limestone			
40.0	60.0	Yellow gray shale			
60.0	102.0	Blue gray shale grading downward to blue black			
102.0	117.0	Lighter gray shale			
117.0	122.0	Brownish reddish shale and clay with green inclusions			
122.0	138.0	Light gray shale			
138.0	143.0	Darker gray shale			
143.0	160.0	Light gray shale becoming darker downward			

7 CONTRACTOR'S OR LANDOWNER'S CERTIFICATION: This water well was (1) constructed (2) reconstructed, or (3) plugged under my jurisdiction and was completed on (mo/day/year) 2/21/95 and this record is true to the best of my knowledge and belief. Kansas

Water Well Contractor's License No. 279 This Water Well Record was completed on (mo/day/yr) 2/23/95

under the business name of Fudge Drilling by (signature) *Melvin R. Fudge*