


1 LOCATION OF WATER WELL: County: <i>Butler</i>	Fraction <i>NW 1/4 NW 1/4 NW 1/4</i>	Section Number <i>33</i>	Township Number T <i>26</i> S	Range Number R <i>4</i> (E) W
--	---	-----------------------------	----------------------------------	----------------------------------

Distance and direction from nearest town or city, street address of well if located within city?

2 WATER WELL OWNER: Rick Sanger Rose Hill Kan
RR#, St. Address, Box # :
City, State, ZIP Code : 413 N Morris
Board of Agriculture, Division of Water Resources
Application Number:

LOCATE WELL'S LOCATION WITH AN "X" IN SECTION BOX: 4 DEPTH OF COMPLETED WELL: 125 ft. ELEVATION: _____

Depth(s) Groundwater Encountered: 1. 100 ft. 2. _____ ft. 3. _____ ft.

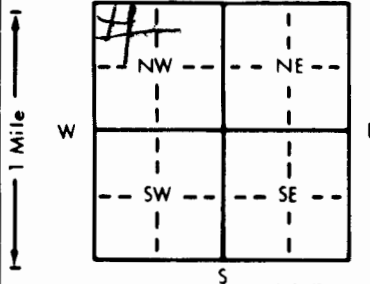

4 DEPTH OF COMPLETED WELL 125 ft. ELEVATION: _____
 Depth(s) Groundwater Encountered 1. 100 ft. 2. _____ ft. 3. _____ ft.
 WELL'S STATIC WATER LEVEL 40 ft. below land surface measured on mo/day/yr _____
 Pump test data: Well water was _____ ft. after _____ hours pumping _____ gpm
 Est. Yield 45 gpm Well water was _____ ft. after _____ hours pumping _____ gpm
 Bore Hole Diameter 9 1/2 in. to _____ ft. and _____ in. to _____ ft.
 WELL WATER TO BE USED AS: 5 Public water supply ☒ 8 Air conditioning 11 Injection well
 1 Domestic 3 Feedlot 6 Oil field water supply 9 Dewatering 12 Other (Specify below)
 2 Irrigation 4 Industrial 7 Lawn and garden only 10 Monitoring well _____
 Was a chemical/bacteriological sample submitted to Department? Yes _____ No ☒ If yes, mo/day/yr sample was sub-
 mitted _____ Water Well Disinfected? Yes ☒ No _____

5	TYPE OF BLANK CASING USED:	5 Wrought iron	8 Concrete tile	CASING JOINTS: Glued <input checked="" type="checkbox"/> . . . Clamped
	1 Steel	6 Asbestos-Cement	9 Other (specify below)	Welded
	2) PVC	7 Fiberglass		Threaded
	3 RMP (SR)			
	4 ABS			

Blank casing diameter 3 in. to _____ ft., Dia _____ in. to _____ ft., Dia _____ in. to _____ ft.
Casing height above land surface 18 in., weight 160 lbs./ft. Wall thickness or gauge No. 214

TYPE OF SCREEN OR PERFORATION MATERIAL:			<u>1</u> PVC	10 Asbestos-cement
1 Steel	3 Stainless steel	5 Fiberglass	8 RMP (SR)	11 Other (specify)
2 Brass	4 Galvanized steel	6 Concrete tile	9 ABS	12 None used (open hole)

SCREEN OR PERFORATION OPENINGS ARE:

1 Continuous slot	3 Mill slot	5 Gauzed wrapped	8 Saw cut	11 None (open hole)
2 Louvered shutter	4 Key punched	6 Wire wrapped	9 Drilled holes	
		7 Torch cut	10 Other (specify)	

SCREEN-PERFORATED INTERVALS:	From ft. to ft.,	From ft. to ft.
	From ft. to ft.,	From ft. to ft.
GRAVEL PACK INTERVALS:	From ft. to ft.,	From ft. to ft.
	From ft. to ft.,	From ft. to ft.

6 GROUT MATERIAL: 1 Neat cement 2 Cement grout 3 Bentonite 4 Other
Grout Intervals: From 0 ft. to 23 ft., From ft. to ft., From ft. to ft.

What is the nearest source of possible contamination:

1 Septic tank	4 Lateral lines	7 Pit privy	10 Livestock pens	14 Abandoned water well
2 Sewer lines	5 Cess pool	8 Sewage lagoon	11 Fuel storage	15 Oil well/Gas well
3 Watertight sewer lines	6 Seepage pit	9 Feedyard	12 Fertilizer storage	16 Other (specify below)
			13 Insecticide storage	

Direction from well?		<i>East</i>		How many feet?		<i>200</i>	
FROM	TO	LITHOLOGIC LOG		FROM	TO	PLUGGING INTERVALS	

[illegible]

7 CONTRACTOR'S OR LANDOWNER'S CERTIFICATION: This water well was (1) constructed, (2) reconstructed, or (3) plugged under my jurisdiction and was completed on (mo/day/year) 11/29/91 and this record is true to the best of my knowledge and belief. Kansas Water Well Contractor's License No. 251 This Water Well Record was completed on (mo/day/yr) 2/6/87 under the business name of Winter Well Drill by (signature) Charles Winter