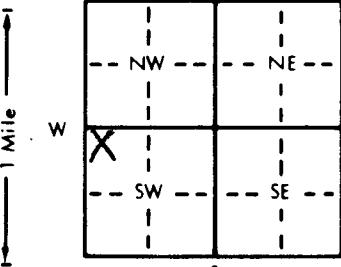


1 LOCATION OF WATER WELL:		Fraction County: <i>Butler</i>	NW $\frac{1}{4}$	NW $\frac{1}{4}$	SW $\frac{1}{4}$	Section Number 35	Township Number T 26 S	Range Number R 4 E	
Distance and direction from nearest town or city street address of well if located within city? <i>15 miles N. Augusta, KS on Ohio St.</i>									
2 WATER WELL OWNER:		<i>Verlyn C. Coshenberry</i>			Board of Agriculture, Division of Water Resources				
RR#, St. Address, Box #:		<i>9630 Southwest Boulevard</i>			Application Number:				
City, State, ZIP Code:		<i>Wichita, KS 67215</i>							
3 LOCATE WELL'S LOCATION WITH AN "X" IN SECTION BOX:					4 DEPTH OF COMPLETED WELL 110 ft. ELEVATION: Depth(s) Groundwater Encountered 1. 95 ft. ft. 2. ft. ft. WELL'S STATIC WATER LEVEL 12 ft. below land surface measured on mo/day/yr Pump test data: Well water was ft. after hours pumping gpm Est. Yield 60 gpm: Well water was ft. after hours pumping gpm Bore Hole Diameter 10 in. to ft. and in. to ft. WELL WATER TO BE USED AS: 5 Public water supply 8 Air conditioning 11 Injection well 1 Domestic 3 Feedlot 6 Oil field water supply 9 Dewatering 12 Other (Specify below) 2 Irrigation 4 Industrial 0 Lawn and garden only 10 Monitoring well Was a chemical/bacteriological sample submitted to Department? Yes No ✓ If yes, mo/day/yr sample was submitted Water Well Disinfected? Yes No				
5 TYPE OF BLANK CASING USED:		1 Steel	3 RMP (SR)	5 Wrought iron	8 Concrete tile	CASING JOINTS: Glued Clamped			
		0 PVC	4 ABS	6 Asbestos-Cement	9 Other (specify below)	Welded Threaded			
Blank casing diameter		5	in. to ft.	Dia in. to ft.	Dia in. to ft.				
Casing height above land surface		12	in., weight 160	lbs./ft. Wall thickness or gauge No.					
TYPE OF SCREEN OR PERFORATION MATERIAL:								10 Asbestos-cement	
1 Steel		3 Stainless steel	5 Fiberglass	8 RMP (SR)	11 Other (specify)				
2 Brass		4 Galvanized steel	6 Concrete tile	9 ABS	12 None used (open hole)				
SCREEN OR PERFORATION OPENINGS ARE:		5 Gauzed wrapped 8 Saw cut 11 None (open hole) 6 Wire wrapped 9 Drilled holes 7 Torch cut 10 Other (specify)							
1 Continuous slot		0 Mill slot	5 Fiberglass	8 RMP (SR)	11 Other (specify)				
2 Louvered shutter		4 Key punched	6 Concrete tile	9 ABS	12 None used (open hole)				
SCREEN-PERFORATED INTERVALS:		From 90	ft. to 110	ft., From ft. to ft.	ft., From ft. to ft.				
GRAVEL PACK INTERVALS:		From 20	ft. to 110	ft., From ft. to ft.	ft., From ft. to ft.				
From		ft. to	ft.	ft., From	ft. to				
6 GROUT MATERIAL:		1 Neat cement	2 Cement grout	0 Bentonite	4 Other				
Grout Intervals:		From 3	ft. to 20	ft., From ft. to ft., From ft. to ft.	ft., From ft. to ft.				
What is the nearest source of possible contamination:									
1 Septic tank		4 Lateral lines	7 Pit privy	10 Livestock pens	14 Abandoned water well				
2 Sewer lines		5 Cess pool	0 Sewage lagoon	11 Fuel storage	15 Oil well/Gas well				
3 Watertight sewer lines		6 Seepage pit	9 Feedyard	12 Fertilizer storage	16 Other (specify below)				
13 Insecticide storage How many feet? 100+									
Direction from well?									
FROM	TO	LITHOLOGIC LOG			FROM	TO	PLUGGING INTERVALS		
0	3	dirt							
3	15	weathered rock							
15	20	lime							
20	26	green shale							
26	48	red clay							
48	60	shaly lime							
60	95	light & dark shale							
95	110	lime water in yellow lime							

7 CONTRACTOR'S OR LANDOWNER'S CERTIFICATION: This water well was (1) constructed, (2) reconstructed, or (3) plugged under my jurisdiction and was completed on (mo/day/year) *5/15/99* and this record is true to the best of my knowledge and belief. Kansas Water Well Contractor's License No. *493* This Water Well Record was completed on (mo/day/year) *5/15/99* by (signature) *Jeffrey Reisner* under the business name of *Reisner Well Drilling*