

1 LOCATION OF WATER WELL:

Fraction

NE 1/4 NE 1/4 NE 1/4

Section Number

1

Township Number

T 26 S

Range Number

R 4 E

County: Butler  
Distance and direction from nearest town or city street address of well if located within city?

3 W of Eldorado

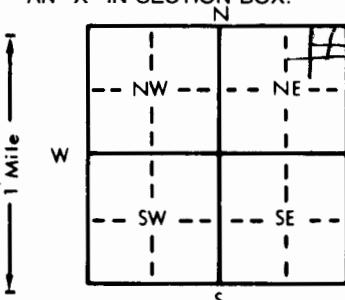
67144

2 WATER WELL OWNER:

David Ticker

RR#, St. Address, Box #

Box 371 Tawanda Kan

Board of Agriculture, Division of Water Resources  
Application Number:3 LOCATE WELL'S LOCATION WITH  
AN "X" IN SECTION BOX:

4 DEPTH OF COMPLETED WELL: 125 ft. ELEVATION: .....

Depth(s) Groundwater Encountered 1. 85 ft. 2. ft. 3. ft.

WELL'S STATIC WATER LEVEL 40 ft. below land surface measured on mo/day/yr

Pump test data: Well water was ft. after hours pumping gpm

Est. Yield 50 gpm: Well water was ft. after hours pumping gpm

Bore Hole Diameter 8.5 in. to ft., and in. to ft.

WELL WATER TO BE USED AS: 5 Public water supply 8 Air conditioning 11 Injection well

1 Domestic 3 Feedlot 6 Oil field water supply 9 Dewatering 12 Other (Specify below)

2 Irrigation 4 Industrial 7 Lawn and garden only 10 Observation well

Was a chemical/bacteriological sample submitted to Department? Yes  No  If yes, mo/day/yr sample was submittedWater Well Disinfected?  Yes  No

5 TYPE OF BLANK CASING USED:

1 Steel  3 RMP (SR)  
2 PVC  4 ABS

5 Wrought iron  
6 Asbestos-Cement  
7 Fiberglass  
8 Concrete tile  
9 Other (specify below)

CASING JOINTS: Glued  Clamped   
Welded   
Threaded

Blank casing diameter 5 in. to 12.5 ft. Dia in. to ft. Dia in. to ft.

Casing height above land surface 18 in., weight 200 lbs./ft. Wall thickness or gauge No. 214

TYPE OF SCREEN OR PERFORATION MATERIAL:

1 Steel 3 Stainless steel  
2 Brass 4 Galvanized steel

5 Fiberglass  
6 Concrete tile  
7 PVC  
8 RMP (SR)  
9 ABS

10 Asbestos-cement  
11 Other (specify)  
12 None used (open hole)

SCREEN OR PERFORATION OPENINGS ARE:

1 Continuous slot 3 Mill slot  
2 Louvered shutter 4 Key punched

5 Gauzed wrapped  
6 Wire wrapped  
7 Torch cut

8 Saw cut  
9 Drilled holes  
10 Other (specify)

SCREEN-PERFORATED INTERVALS: From 60 ft. to 90 ft. From ft. to ft. From ft. to ft.

From ft. to ft. From ft. to ft. From ft. to ft.

GRAVEL PACK INTERVALS: From ft. to ft. From ft. to ft. From ft. to ft. From ft. to ft.

From ft. to ft. From ft. to ft. From ft. to ft.

6 GROUT MATERIAL: 1 Neat cement  2 Cement grout  3 Bentonite  4 Other 

Grout Intervals: From 3 ft. to 14 ft., From ft. to ft., From ft. to ft., From ft. to ft.

What is the nearest source of possible contamination:

1 Septic tank 4 Lateral lines  
2 Sewer lines 5 Cess pool  
3 Watertight sewer lines 6 Seepage pit

7 Pit privy  
8 Sewage lagoon  
9 Feedyard

10 Livestock pens  
11 Fuel storage  
12 Fertilizer storage  
13 Insecticide storage  
14 Abandoned water well  
15 Oil well/Gas well  
16 Other (specify below)

Direction from well? N

How many feet? 150

FROM	TO	LITHOLOGIC LOG	FROM	TO	LITHOLOGIC LOG
0	3	SOIL			
3	7	CLAY			
7	21	ROCK & CLAY			
21	32	CLAY			
32	65	SHALE			
65	105	LIME			
105	125	SHALE			

7 CONTRACTOR'S OR LANDOWNER'S CERTIFICATION: This water well was  (1) constructed, (2) reconstructed, or (3) plugged under my jurisdiction and was completed on (mo/day/year) 5/18/82 and this record is true to the best of my knowledge and belief. Kansas

Water Well Contractor's License No. 251 This Water Well Record was completed on (mo/day/year) 6/29/82 under the business name of Winter Well Drilling by (signature) Charles Winter

INSTRUCTIONS: Use typewriter or ball point pen, PLEASE PRESS FIRMLY and PRINT clearly. Please fill in blanks, underline or circle the correct answers. Send top three copies to Kansas Department of Health and Environment, Division of Environment, Environmental Geology Section, Topeka, KS 66620. Send one to WATER WELL OWNER and retain one for your records.