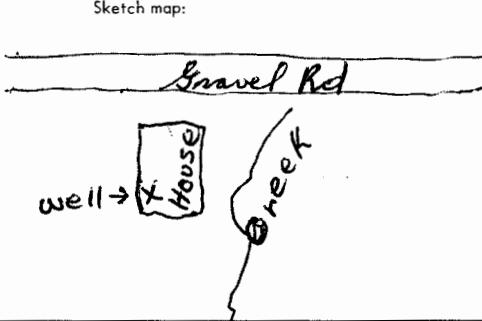
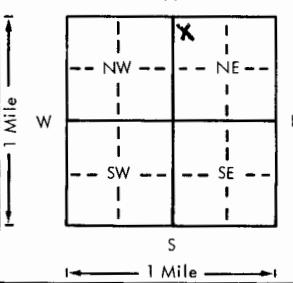


USE TYPEWRITER OR BALL
POINT PEN-PRESS FIRMLY,
PRINT CLEARLY.

WATER WELL RECORD
KSA 82a-1201-1215

Kansas Department of Health and
Environment-Division of Environment
(Water well Contractors)
Topeka, Kansas 66620

1. Location of well:	County <i>Butler</i>	Fraction <i>NW 1/4 NW 1/4 NE 1/4</i>	Section number <i>5</i>	Township number <i>T 26 S R 4</i>	Range number <i>E</i>
2. Distance and direction from nearest town or city:	<i>KANSAS CITY 25.4 Mi. Then 2 mi N + 1/2 mi</i>		3. Owner of well: R.R. or street: <i>BERT PERSON'S</i>	3. Owner of well: R.R. or street: <i>328 80. Bluff Wichita</i>	
Street address or well location if in city: <i>WEST on SO side of ROAD</i>			City, state, zip code: <i>WICHITA KS</i>		
4. Locate with "X" in section below:	Sketch map: 				
			6. Bore hole dia. <u>10</u> in. Completion date Well depth <u>150</u> ft. <u>6-20-80</u>		
			7. <input checked="" type="checkbox"/> Cable tool <input type="checkbox"/> Rotary <input type="checkbox"/> Driven <input type="checkbox"/> Dug <input type="checkbox"/> Hollow rod <input type="checkbox"/> Jetted <input type="checkbox"/> Bored <input type="checkbox"/> Reverse rotary		
			8. Use: <input checked="" type="checkbox"/> Domestic <input type="checkbox"/> Public supply <input type="checkbox"/> Industry <input type="checkbox"/> Irrigation <input checked="" type="checkbox"/> Air conditioning <input type="checkbox"/> Stock <input type="checkbox"/> Lawn <input type="checkbox"/> Oil field water <input type="checkbox"/> Other		
			9. Casing: Material <u>PLIS</u> Height: Above or below Threaded <input type="checkbox"/> Welded <input type="checkbox"/> Surface <u>96</u> in. RMP <input type="checkbox"/> PVC <input type="checkbox"/> Weight <input type="checkbox"/> lbs./ft. Dia. <u>5</u> in. to <u>150</u> ft. depth Wall Thickness: inches or Dia. <input type="checkbox"/> in. to <input type="checkbox"/> ft. depth Gage No. <input type="checkbox"/>		
			10. Screen: Manufacturer's name <i>St. Joe well Jess</i>		
			Type <u>5"</u> Dia. <u>5"</u> Slot/gauze <u>1/16</u> Length <u>20 ft</u> Set between <u>130</u> ft. and <u>150</u> ft. ft. and <u>150</u> ft. Gravel pack? <input checked="" type="checkbox"/> Size range of material <u>8 to 14</u>		
			11. Static water level: mo./day/yr. <u>12</u> ft. below land surface Date <u>6-19-80</u>		
			12. Pumping level below land surfaces: ft. after <input type="checkbox"/> hrs. pumping <input type="checkbox"/> g.p.m. ft. after <input type="checkbox"/> hrs. pumping <input type="checkbox"/> g.p.m. Estimated maximum yield <input type="checkbox"/> g.p.m.		
			13. Water sample submitted: mo./day/yr. Yes <input checked="" type="checkbox"/> No <input type="checkbox"/> Date		
			14. Well head completion: Pitless adapter <input type="checkbox"/> inches above grade		
			15. Well grouted? <input checked="" type="checkbox"/> With: <input type="checkbox"/> Neat cement <input type="checkbox"/> Bentonite <input checked="" type="checkbox"/> Concrete Depth: From <u>8</u> ft. to <u>18</u> ft.		
			16. Nearest source of possible contamination: ft. <u>50</u> Direction <u>EAST</u> Type <u>Creek</u> Well disinfected upon completion? <input checked="" type="checkbox"/> Yes <input type="checkbox"/> No		
			17. Pump: Manufacturer's name <input checked="" type="checkbox"/> Not installed Model number <input type="checkbox"/> HP <input type="checkbox"/> Volts <input type="checkbox"/> Length of drop pipe <input type="checkbox"/> ft. capacity <input type="checkbox"/> g.p.m. Type: <input type="checkbox"/> Submersible <input type="checkbox"/> Turbine <input type="checkbox"/> Jet <input type="checkbox"/> Reciprocating <input type="checkbox"/> Centrifugal <input type="checkbox"/> Other		
(Use a second sheet if needed)			20. Water well contractor's certification: This well was drilled under my jurisdiction and this report is true to the best of my knowledge and belief. <i>B+J Well Drill 335</i>		
18. Elevation:	19. Remarks: <i>well was drilled in Basement</i>		Business name <i>B#1</i> License No. Address <i>B#1</i> Date <i>6-23-80</i> Signed <i>Bart Ziegler</i> Authorized representative		
Topography:	<input type="checkbox"/> Hill <input type="checkbox"/> Slope <input type="checkbox"/> Upland <input type="checkbox"/> Valley				