

1 LOCATION OF WATER WELL:

Fraction

SE<sub>1/4</sub> NE<sub>1/4</sub> SW<sub>1/4</sub>

Section Number

Township Number

Range Number

County: Benton

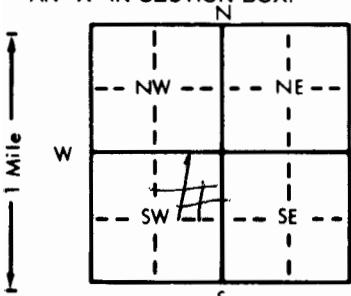
T 26 S

R 4 E

Distance and direction from nearest town or city street address of well if located within city?

3 mile west 2 N of Towanda

2 WATER WELL OWNER:

Locis & Lette Jr. 69144  
RI Box 2 Towanda KanBoard of Agriculture, Division of Water Resources  
Application Number:RR#, St. Address, Box # :  
City, State, ZIP Code :3 LOCATE WELL'S LOCATION WITH  
AN "X" IN SECTION BOX:

4 DEPTH OF COMPLETED WELL . . . 105 ft. ELEVATION: . . . . .

Depth(s) Groundwater Encountered 1. 85 ft. 2. . . . . ft. 3. . . . . ft.

WELL'S STATIC WATER LEVEL 30 ft. below land surface measured on mo/day/yr . . . . .

Pump test data: Well water was . . . . . ft. after . . . . . hours pumping . . . . . gpm

Est. Yield 50 gpm. Well water was . . . . . ft. after . . . . . hours pumping . . . . . gpm

Bore Hole Diameter 85 in. to . . . . . ft., and . . . . . in. to . . . . . ft.

WELL WATER TO BE USED AS: 5 Public water supply 8 Air conditioning 11 Injection well

① Domestic 3 Feedlot 6 Oil field water supply 9 Dewatering 12 Other (Specify below)

2 Irrigation 4 Industrial 7 Lawn and garden only 10 Observation well

Was a chemical/bacteriological sample submitted to Department? Yes . . . . . No . . . . . If yes, mo/day/yr sample was submitted

Water Well Disinfected? Yes . . . . . No

5 TYPE OF BLANK CASING USED:

1 Steel 3 RMP (SR)  
2 PVC 4 ABS

5 Wrought iron 8 Concrete tile Casing joints: Glued . . . . . Clamped . . . . .

6 Asbestos-Cement 9 Other (specify below) Welded . . . . .

7 Fiberglass . . . . . Threaded . . . . .

Blank casing diameter 5 in. to 105 ft. Dia . . . . . in. to . . . . . ft. Dia . . . . . in. to . . . . . ft.

Casing height above land surface 18 in., weight 20.4 lbs./ft. Wall thickness or gauge No. 1214

TYPE OF SCREEN OR PERFORATION MATERIAL:

1 Steel 3 Stainless steel 5 Fiberglass 7 PVC 10 Asbestos-cement

2 Brass 4 Galvanized steel 6 Concrete tile 8 RMP (SR) 11 Other (specify) . . . . .

3 SCREEN OR PERFORATION OPENINGS ARE: 9 ABS 12 None used (open hole)

1 Continuous slot 3 Mill slot 5 Gauzed wrapped ⑧ Saw cut 11 None (open hole)

2 Louvered shutter 4 Key punched 6 Wire wrapped 9 Drilled holes

3 SCREEN-PERFORATED INTERVALS: From . . . . . 60 ft. to . . . . . 95 ft. From . . . . . ft. to . . . . . ft.

From . . . . . ft. to . . . . . ft. From . . . . . ft. to . . . . . ft.

4 GRAVEL PACK INTERVALS: From . . . . . 20 ft. to . . . . . 105 ft. From . . . . . ft. to . . . . . ft.

From . . . . . ft. to . . . . . ft. From . . . . . ft. to . . . . . ft.

5 GROUT MATERIAL: 1 Neat cement ② Cement grout 3 Bentonite 4 Other . . . . .

Grout Intervals: From . . . . . 3 ft. to . . . . . 14 ft. From . . . . . ft. to . . . . . ft. From . . . . . ft. to . . . . . ft.

What is the nearest source of possible contamination: 10 Livestock pens 14 Abandoned water well

1 Septic tank 4 Lateral lines 7 Pit privy 11 Fuel storage 15 Oil well/Gas well

2 Sewer lines 5 Cess pool 8 Sewage lagoon 12 Fertilizer storage 16 Other (specify below)

3 Watertight sewer lines 6 Seepage pit 9 Feedyard 13 Insecticide storage

How many feet? 150

Direction from well? E

FROM TO LITHOLOGIC LOG FROM TO LITHOLOGIC LOG

0 2 Soil

2 15 Clay

15 30 Clay &amp; Sand

30 60 Shale

60 90 Lime

90 105 Shale

7 CONTRACTOR'S OR LANDOWNER'S CERTIFICATION: This water well was ① constructed, (2) reconstructed, or (3) plugged under my jurisdiction and was completed on (mo/day/year) 5-4-82 and this record is true to the best of my knowledge and belief. Kansas

Water Well Contractor's License No. 257 This Water Well Record was completed on (mo/day/year) 6-29-82  
under the business name of Winter Well Drilling by (signature) Charles Winter

INSTRUCTIONS: Use typewriter or ball point pen, PLEASE PRESS FIRMLY and PRINT clearly. Please fill in blanks, underline or circle the correct answers. Send top three copies to Kansas Department of Health and Environment, Division of Environment, Environmental Geology Section, Topeka, KS 66620. Send one to WATER WELL OWNER and retain one for your records.