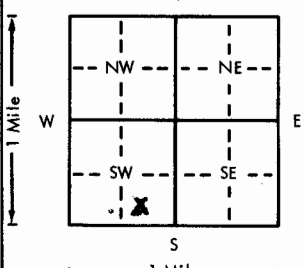


USE TYPEWRITER OR BALL
POINT PEN-PRESS FIRMLY,
PRINT CLEARLY.

WATER WELL RECORD
KSA 82a-1201-1215

Kansas Department of Health and
Environment-Division of Environment
(Water well Contractors)
Topeka, Kansas 66620

1. Location of well:		County Butler	Fraction SW 1/4 SE 1/4 SW 1/4	Section number 7	Township number T 26 S R 4	Range number 4	EW
2. Distance and direction from nearest town or city: 1 1/2 mi NW			3. Owner of well: Dale Coulson				
Street address of well location if in city: Towanda			R.R. or street: Route 3 Box 136				
			City, state, zip code: Augusta				
4. Locate with "X" in section below:		Sketch map:		6. Bore hole dia. 10 in. Completion date 3-30-76			
		Well in wheat field		Well depth 90 ft.			
5. Type and color of material		From	To	7. <input checked="" type="checkbox"/> Cable tool <input type="checkbox"/> Rotary <input type="checkbox"/> Driven <input type="checkbox"/> Dug			
				<input type="checkbox"/> Hollow rod <input type="checkbox"/> Jetted <input type="checkbox"/> Bored <input type="checkbox"/> Reverse rotary			
				8. Use: <input checked="" type="checkbox"/> Domestic <input type="checkbox"/> Public supply <input type="checkbox"/> Industry			
				<input type="checkbox"/> Irrigation <input type="checkbox"/> Air conditioning <input type="checkbox"/> Stock			
				<input type="checkbox"/> Lawn <input type="checkbox"/> Oil field water <input type="checkbox"/> Other			
				9. Casing: Material plb Height Above or below			
				Threaded <input type="checkbox"/> Welded <input type="checkbox"/> Surface 16 in.			
				RMP <input checked="" type="checkbox"/> PVC <input type="checkbox"/> Weight 16 lbs./ft.			
				Dia. 6 in. to 90 ft. depth Wall Thickness: inches or			
				Dia. 6 in. to 90 ft. depth gage No. 175			
				10. Screen: Manufacturer's name g & L Oklahoma City			
				Type RMP Dia. 6			
				Slo gauge 1/16 Length 20 ft			
				Set between 70 ft. and 90 ft.			
				ft. and 90 ft.			
				Gravel pack? no Size range of material no			
				11. Static water level: 37 ft. below land surface Date 3-30-76			
				12. Pumping level below land surfaces:			
				ft. after 16 hrs. pumping 20 ft g.p.m.			
				ft. after 16 hrs. pumping 20 ft g.p.m.			
				Estimated maximum yield 20 ft g.p.m.			
				13. Water sample submitted: no mo./day/yr.			
				Yes <input checked="" type="checkbox"/> No <input type="checkbox"/> Date 3-30-76			
				14. Well head completion: 16 inches above grade			
				Pitless adapter 16 inches above grade			
				15. Well grouted? <input checked="" type="checkbox"/> Yes			
				With: <input checked="" type="checkbox"/> Neat cement <input type="checkbox"/> Bentonite <input type="checkbox"/> Concrete			
				Depth: From 12 ft. to 0 ft.			
				16. Nearest source of possible contamination: Field mo.			
				ft. 12 Direction Field Type Field			
				Well disinfected upon completion? <input checked="" type="checkbox"/> Yes <input type="checkbox"/> No			
				17. Pump: <input checked="" type="checkbox"/> Not installed			
				Type: <input type="checkbox"/> Submersible <input type="checkbox"/> Turbine			
				<input type="checkbox"/> Jet <input type="checkbox"/> Reciprocating			
				<input type="checkbox"/> Centrifugal <input type="checkbox"/> Other			
18. Elevation:		19. Remarks:		20. Water well contractor's certification:			
Topography:		concrete slab to be installed		This well was drilled under my jurisdiction and this report			
<input type="checkbox"/> Hill		owner		is true to the best of my knowledge and belief.			
<input type="checkbox"/> Slope		Dale Coulson		Wibe Well Drilling 122 License No.			
<input checked="" type="checkbox"/> Upland				Business name Wibe Well Drilling			
<input type="checkbox"/> Valley				Address Route 3 Augusta			
				Signed Wibe Well Drilling Date 3-30-76			
				Authorized representative Wibe Well Drilling			

26
4
7
SW SE SW
1/4 1/4 1/4