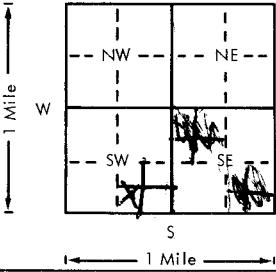
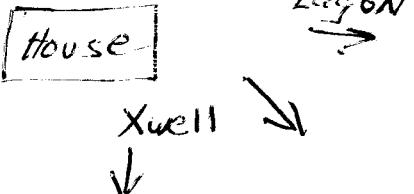


X Location of well:		County	Fraction	Section number	Township number	Range number
		Butler	SW _{1/4} SE _{1/4} SW _{1/4}	7	T 26	S R 4 E/W
2. Distance and direction from nearest town or city: 2W 16N 1/4W of Towanda Ks.			3. Owner of well: CLINTON LAYMON R.R. or street: RR 1 City, state, zip code: Towanda KS 67144			
4. Locate with "X" in section below:		Sketch map:		6. Bore hole dia. 8.5 in. Completion date 8-22-78 Well depth 62 ft.		
				7. X Cable tool <input type="checkbox"/> Rotary <input type="checkbox"/> Driven <input type="checkbox"/> Dug <input type="checkbox"/> Hollow rod <input type="checkbox"/> Jetted <input type="checkbox"/> Bored <input type="checkbox"/> Reverse rotary		
5. Type and color of material		From	To	8. Use: X Domestic <input type="checkbox"/> Public supply <input type="checkbox"/> Industry <input type="checkbox"/> Irrigation <input type="checkbox"/> Air conditioning <input type="checkbox"/> Stock <input type="checkbox"/> Lawn <input type="checkbox"/> Oil field water <input type="checkbox"/> Other		
Limestone with clay light yellow		0	12	9. Casing: Material PITS <input type="checkbox"/> Height: Above or below Threaded <input type="checkbox"/> Welded <input checked="" type="checkbox"/> Surface 24 in. RMP X PVC <input type="checkbox"/> Weight _____ lbs./ft. Dia. 5 in. to 62 ft. depth Wall Thickness: inches or Dia. _____ in. to _____ ft. depth gage No. 200		
Rusty Red Shale		12	25	10. Screen: Manufacturer's name SUNFLOWER PITS PIPE INC Type RMP <input type="checkbox"/> Dia. 5 Slot/gauge 1/16 <input type="checkbox"/> Length 10 Set between 52 ft. and 62 ft. ft. and _____ ft. Gravel pack? X Size range of material 15-24		
Shale gray		25	30	11. Static water level: _____ mo./day/yr. 415 ft. below land surface Date 8-22-78		
Limestone with clay yellow		30	50	12. Pumping level below land surfaces: N4 _____ ft. after _____ hrs. pumping _____ g.p.m. _____ ft. after _____ hrs. pumping _____ g.p.m. Estimated maximum yield _____ g.p.m.		
Limestone yellow		50	60	13. Water sample submitted: _____ mo./day/yr. Yes X No _____ Date _____		
Clay gray		60	62	14. Well head completion: _____ X Pitless adapter 24 Inches above grade		
				15. Well grouted? X With: Neat cement <input type="checkbox"/> Bentonite <input checked="" type="checkbox"/> Concrete Depth: From 13 ft. to 3 ft.		
				16. Nearest source of possible contamination: ft. 200 Direction NE Type Lagoon Well disinfected upon completion? X Yes _____ No _____		
				17. Pump: X Not installed Manufacturer's name _____ Model number _____ HP _____ Volts _____ Length of drop pipe _____ ft. capacity _____ g.p.m. Type: <input type="checkbox"/> Submersible <input type="checkbox"/> Turbine <input type="checkbox"/> Jet <input type="checkbox"/> Reciprocating <input type="checkbox"/> Centrifugal <input type="checkbox"/> Other		
				18. Elevation: 19. Remarks: OWNER will install concrete slab		
				20. Water well contractor's certification: This well was drilled under my jurisdiction and this report is true to the best of my knowledge and belief. Braddy Water Wells 363 Business name _____ License No. _____ Address: P.O. Box 217 A Dodge City Signed: Richard Braddy Date 8-22-78 Authorized representative _____		
<p>(Use a second sheet if needed)</p> <p>Topography: <input type="checkbox"/> Hill X Slope <input type="checkbox"/> Upland <input type="checkbox"/> Valley</p>						