

1 LOCATION OF WATER WELL:	Fraction	Section Number	Township Number	Range Number
County: <u>Butler</u>	<u>SE 1/4 NE 1/4 NE 1/4</u>	<u>7</u>	T <u>26</u> S	R <u>4</u> EW

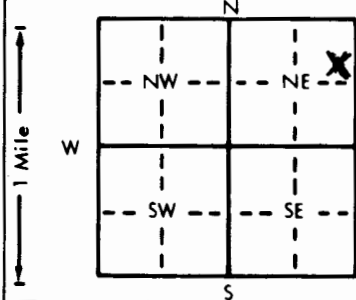
Distance and direction from nearest town or city street address of well if located within city?

1W 1/2 N 4W 1/2 N Towards West side

2 WATER WELL OWNER:	Board of Agriculture, Division of Water Resources
RR#, St. Address, Box # :	Application Number:
City, State, ZIP Code :	

David DelayRR#1Towards, KS 67144

3 LOCATE WELL'S LOCATION WITH AN "X" IN SECTION BOX:	4 DEPTH OF COMPLETED WELL: <u>96</u> ft. ELEVATION:
--	---

Depth(s) Groundwater Encountered 1. 80 ft. 2. ft. 3. ft.WELL'S STATIC WATER LEVEL 22 ft. below land surface measured on mo/day/yr 3/20/90

Pump test data: Well water was ft. after hours pumping gpm

Est. Yield 4.0 gpm: Well water was ft. after hours pumping gpmBore Hole Diameter 10 in. to ft., and in. to ft.

WELL WATER TO BE USED AS:

<u>1 Domestic</u>	3 Feedlot	6 Oil field water supply	9 Dewatering	11 Injection well
2 Irrigation	4 Industrial	7 Lawn and garden only	10 Monitoring well	12 Other (Specify below)

Was a chemical/bacteriological sample submitted to Department? Yes. No. Yes If yes, mo/day/yr sample was submittedWater Well Disinfected Yes No

5 TYPE OF BLANK CASING USED:	5 Wrought iron	8 Concrete tile	CASING JOINTS: Glued <u>Yes</u> Clamped
------------------------------	----------------	-----------------	---

1 Steel 3 RMP (SR) 6 Asbestos-Cement 9 Other (specify below) Welded

2 PVC 4 ABS 7 Fiberglass ThreadedBlank casing diameter 5 in. to ft., Dia in. to ft., Dia in. to ft.Casing height above land surface +12 in., weight 160 lbs./ft. Wall thickness or gauge No.

TYPE OF SCREEN OR PERFORATION MATERIAL:	7 PVC	10 Asbestos-cement
---	-------	--------------------

1 Steel 3 Stainless steel 5 Fiberglass 8 RMP (SR) 11 Other (specify)

2 Brass 4 Galvanized steel 6 Concrete tile 9 ABS 12 None used (open hole)

SCREEN OR PERFORATION OPENINGS ARE:	5 Gauzed wrapped	8 Saw cut	11 None (open hole)
-------------------------------------	------------------	-----------	---------------------

1 Continuous slot 3 Mill slot 6 Wire wrapped 9 Drilled holes

2 Louvered shutter 4 Key punched 7 Torch cut 10 Other (specify)

SCREEN-PERFORATED INTERVALS:	From <u>76</u> ft. to <u>96</u> ft.	From ft. to ft.
------------------------------	-------------------------------------	-----------------

From ft. to ft. From ft. to ft.

GRAVEL PACK INTERVALS: From 20 ft. to 96 ft. From ft. to ft.

From ft. to ft. From ft. to ft.

6 GROUT MATERIAL:	1 Neat cement	2 Cement grout	<u>3 Bentonite</u>	4 Other
-------------------	---------------	----------------	--------------------	---------

Grout Intervals: From 3 ft. to 20 ft. From ft. to ft. From ft. to ft.

What is the nearest source of possible contamination:

1 Septic tank 4 Lateral lines 7 Pit privy 10 Livestock pens 14 Abandoned water well

2 Sewer lines 5 Cess pool 8 Sewage lagoon 11 Fuel storage 15 Oil well/Gas well

3 Watertight sewer lines 6 Seepage pit 9 Feedyard 12 Fertilizer storage 16 Other (specify below)

Direction from well? DOWN SLOPE How many feet? 68 +

FROM	TO	LITHOLOGIC LOG	FROM	TO	PLUGGING INTERVALS
------	----	----------------	------	----	--------------------

0	10	earth			
10	18	broken yellow rock			
18	70	yellow clay			
70	76	red bed			
76	96	shaly lime			

7 CONTRACTOR'S OR LANDOWNER'S CERTIFICATION:	This water well was (1) constructed, (2) reconstructed, or (3) plugged under my jurisdiction and was completed on (mo/day/year) <u>March 20/90</u> and this record is true to the best of my knowledge and belief. Kansas
--	---

Water Well Contractor's License No. 493 This Water Well Record was completed on (mo/day/yr)under the business name of Bousner Well Drilling by (signature) Ferry Bousner