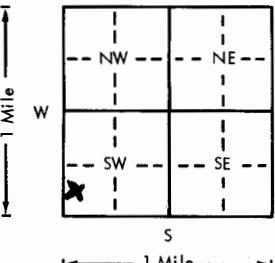
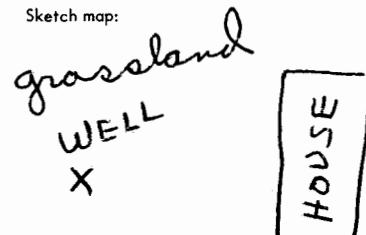


1. Location of well:	County	Fraction	Section number	Township number	Range number
Butler		1/4 SW 1/4 SW 1/4	8	T 26 S R	R 40 E
2. Distance and direction from nearest town or city:	1 M. W 1/4 N	3. Owner of well:	Ken Hartzer		
Street address of well location if in city:	Gowanda	R.R. or street:	400 W Central app 3305		
City, state, zip code:			Wichita Kansas 67203		
4. Locate with "X" in section below:	Sketch map:			6. Bore hole dia. 10 in. Completion date 8-23 1978 Well depth 80 ft.	
				<input checked="" type="checkbox"/> Cable tool <input type="checkbox"/> Rotary <input type="checkbox"/> Driven <input type="checkbox"/> Dug <input type="checkbox"/> Hollow rod <input type="checkbox"/> Jetted <input type="checkbox"/> Bored <input type="checkbox"/> Reverse rotary	
5. Type and color of material	From	To	8. Use: <input checked="" type="checkbox"/> Domestic <input type="checkbox"/> Public supply <input type="checkbox"/> Industry <input type="checkbox"/> Irrigation <input type="checkbox"/> Air conditioning <input type="checkbox"/> Stock <input type="checkbox"/> Lawn <input type="checkbox"/> Oil field water <input type="checkbox"/> Other		
Red Clay	0	6	9. Casing: Material <input checked="" type="checkbox"/> Pitts <input type="checkbox"/> Threaded <input type="checkbox"/> Welded <input type="checkbox"/> Surface 14 in. <input checked="" type="checkbox"/> RMP <input type="checkbox"/> PVC <input type="checkbox"/> Weight lbs./ft. Dia. 6 in. to 60 ft. depth Wall Thickness: inches or Dia. in. to ft. depth gage No. 175		
yellow shale, fine sand	6	42	10. Screen: Manufacturer's name <input checked="" type="checkbox"/> RMP		
feet steel pipe	5	49	Type <input checked="" type="checkbox"/> RMP Dia. 6 <input checked="" type="checkbox"/> Slot/gauze 1460 Length 20 ft. Set between 60 ft. and 88 ft. ft. and ft. Gravel pack? <input checked="" type="checkbox"/> No Size range of material		
yellow lime	49	64	11. Static water level: 33 mo./day/yr. ft. below land surface Date 8-23 1978		
water	64		12. Pumping level below land surfaces: ft. after hrs. pumping g.p.m. ft. after hrs. pumping g.p.m. Estimated maximum yield 20+ g.p.m.		
grey lime	64	73	13. Water sample submitted: mo./day/yr. Yes <input checked="" type="checkbox"/> No Date		
yellow lime	73	76	14. Well head completion: 14 inches above grade Pitless adapter		
Blue shale	76	80	15. Well grouted? <input checked="" type="checkbox"/> Yes With: <input checked="" type="checkbox"/> Neat cement <input type="checkbox"/> Bentonite <input type="checkbox"/> Concrete Depth: From 3 ft. to 13 ft.		
Cement between the two Casings and outside of the steel			16. Nearest source of possible contamination: ft. Direction Type Well disinfected upon completion? <input checked="" type="checkbox"/> Yes <input type="checkbox"/> No		
(Use a second sheet if needed)			17. Pump: <input checked="" type="checkbox"/> Not installed Manufacturer's name Model number HP Volts Length of drop pipe ft. capacity g.p.m. Type: <input type="checkbox"/> Submersible <input type="checkbox"/> Turbine <input type="checkbox"/> Jet <input type="checkbox"/> Reciprocating <input type="checkbox"/> Centrifugal <input type="checkbox"/> Other		
18. Elevation:	19. Remarks:	owner will put on slab			20. Water well contractor's certification: This well was drilled under my jurisdiction and this report is true to the best of my knowledge and belief. Water Well drilling 122 Business name Address R#3 Box 57 Wichita Signed  Murray W. Hartzer Authorized representative 9-1-1978
Topography: <input type="checkbox"/> Hill <input type="checkbox"/> Slope <input checked="" type="checkbox"/> Upland <input type="checkbox"/> Valley					