


1 LOCATION OF WATER WELL:	Fraction	Section Number	Township Number	Range Number
County: BUTLER	SE ¼ SE ¼ NW ¼	15	T 26 S	R 4 E E/W

Distance and direction from nearest town or city street address of well if located within city?

$\frac{1}{2}$ E., $\frac{1}{2}$ S. of Towanda, Ks.

2	WATER WELL OWNER:	Jerry Honas	
	RR#, St. Address, Box # :	1315 Peterson	Board of Agriculture, Division of Water Resources
	City, State, ZIP Code :	Wichita, Ks.	Application Number:

3 LOCATE WELL'S LOCATION WITH AN "X" IN SECTION BOX: 4 DEPTH OF COMPLETED WELL... 130 ft. ELEVATION: 25

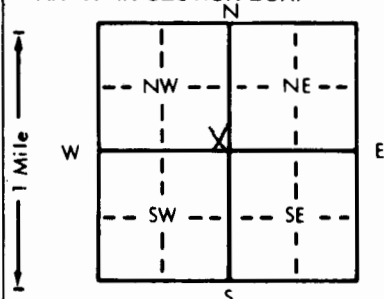

4 DEPTH OF COMPLETED WELL 130 ft. ELEVATION:
 Depth(s) Groundwater Encountered 1. 25 ft. 2. ft. 3. ft.
 WELL'S STATIC WATER LEVEL 25 ft. below land surface measured on mo/day/yr 6/10/81
 Pump test data: Well water was ft. after hours pumping gpm
 Est. Yield gpm: Well water was ft. after hours pumping gpm
 Bore Hole Diameter 11 in. to ft., and in. to ft.
 WELL WATER TO BE USED AS: 5 Public water supply 8 Air conditioning 11 Injection well
☒ Domestic 3 Feedlot 6 Oil field water supply 9 Dewatering 12 Other (Specify below)
 2 Irrigation 4 Industrial 7 Lawn and garden only 10 Observation well Stock Tank
 Was a chemical/bacteriological sample submitted to Department? Yes No ☒; If yes, mo/day/yr sample was submitted
 Water Well Disinfected? Yes ☒ No ☐

5 TYPE OF BLANK CASING USED:		5 Wrought iron	8 Concrete tile	CASING JOINTS: Glued <input checked="" type="checkbox"/> Clamped <input type="checkbox"/>	
1 Steel	3 RMP (SR)	6 Asbestos-Cement	9 Other (specify below)	Welded <input type="checkbox"/>	
2 PVC	4 ABS	7 Fiberglass		Threaded <input type="checkbox"/>	
Blank casing diameter 5 in. to 30 ft., Dia in. to ft., Dia in. to ft.		Cer-Mac Styrene SDR-26			
Casing height above land surface 12 in. weight 1.59 lbs./ft. Wall thickness or gauge No. 203					

TYPE OF SCREEN OR PERFORATION MATERIAL:			7 PVC	10 Asbestos-cement
1 Steel	3 Stainless steel	5 Fiberglass	8 RMP (SR)	11 Other (specify)
2 Brass	4 Galvanized steel	6 Concrete tile	9 ABS	12 None used (open hole)

SCREEN OR PERFORATION OPENINGS ARE:		5 Gauzed wrapped	<u>8 Saw cut</u> .06	11 None (open hole)
1 Continuous slot	3 Mill slot	6 Wire wrapped	9 Drilled holes	
2 Louvered shutter	4 Key punched	7 Torch cut	10 Other (specify)	

SCREEN-PERFORATED INTERVALS:	From 30	ft. to 130	ft., From	ft. to	ft.
	From	ft. to	ft., From	ft. to	ft.
GRAVEL PACK INTERVALS:	From 14	ft. to 130	ft., From	ft. to	ft.
	From	ft. to	ft., From	ft. to	ft.

6	GROUT MATERIAL:	1 Neat cement	2 Cement grout	3 Bentonite	4 Other
	Grout Intervals:	From 40" to 14 ft.	From	ft. to	ft.

What is the nearest source of possible contamination:				No Apparent Source For Contamination.	
1 Septic tank	4 Lateral lines	7 Pit privy	10 Livestock pens	14 Abandoned water well	
2 Sewer lines	5 Cess pool	8 Sewage lagoon	11 Fuel storage	15 Oil well/Gas well	
3 Watertight sewer lines	6 Seepage pit	9 Feedyard	12 Fertilizer storage	16 Other (specify below)	
			13 Insecticide storage	NONE APPARENT	

[illegible][illegible]

7 CONTRACTOR'S OR LANDOWNER'S CERTIFICATION: This water well was (1) constructed, (2) reconstructed, or (3) plugged under my jurisdiction and was completed on (mo/day/year) 6/10/81 and this record is true to the best of my knowledge and belief. Kansas Water Well Contractor's License No. 236 This Water Well Record was completed on (mo/day/yr) 8-6-81 under the business name of Harp Well & Pump Serv., Inc. by (signature) M. Arnold

INSTRUCTIONS: Use typewriter or ball point pen, PLEASE PRESS FIRMLY and PRINT clearly. Please fill in blanks, underline or circle the correct answers. Send top three copies to Kansas Department of Health and Environment, Division of Environment, Environmental Geology Section, Topeka, KS 66620. Send one to WATER WELL OWNER and retain one for your records.