

1 LOCATION OF WATER WELL:

Fraction

SE $\frac{1}{4}$ SE $\frac{1}{4}$ SW $\frac{1}{4}$

Section Number

18

Township Number

T 26 S

Range Number

R 4 C 0

County: Butler

Distance and direction from nearest town or city street address of well if located within city
from Santa Fe Lake Rd & 254 3/4 South on West side approx 300'

2 WATER WELL OWNER:

KEN PARKINS

RR#, St. Address, Box #


City, State, ZIP Code

TOWANDA KS. 67144

Board of Agriculture, Division of Water Resources

Application Number:

3 LOCATE WELL'S LOCATION WITH AN "X" IN SECTION BOX:

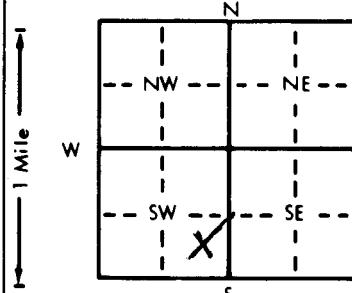

4 DEPTH OF COMPLETED WELL

ft. ELEVATION: 96 ft. Depth(s) Groundwater Encountered 40 ft. ft. 2. 60 ft. ft. 3. 60 ft.

WELL'S STATIC WATER LEVEL 30 ft. below land surface measured on mo/day/yr. Net 6 88

Pump test data: Well water was ft. after hours pumping gpm

Est. Yield 20 gpm: Well water was ft. after hours pumping gpm

Bore Hole Diameter 10 in. to ft., and in. to ft.

WELL WATER TO BE USED AS: 5 Public water supply 8 Air conditioning 11 Injection well

1 Domestic 3 Feedlot 6 Oil field water supply 9 Dewatering 12 Other (Specify below)

2 Irrigation 4 Industrial 7 Lawn and garden only 10 Monitoring well

Was a chemical/bacteriological sample submitted to Department? Yes No. If yes, mo/day/yr sample was submitted

Water Well Disinfected? Yes No

5 TYPE OF BLANK CASING USED:

1 Steel 3 RMP (SR)
2 PVC 4 ABS

5 Wrought iron

6 Asbestos-Cement
7 Fiberglass

CASING JOINTS: Glued Clamped

Welded Threaded

Blank casing diameter 5 in. to ft., Dia in. to ft., Dia in. to ft.

Casing height above land surface +12 in., weight 200 lbs./ft. Wall thickness or gauge No.

TYPE OF SCREEN OR PERFORATION MATERIAL:

1 Steel 3 Stainless steel
2 Brass 4 Galvanized steel5 Fiberglass
6 Concrete tile

7 PVC

10 Asbestos-cement

8 RMP (SR)
9 ABS11 Other (specify)
12 None used (open hole)

SCREEN OR PERFORATION OPENINGS ARE:

1 Continuous slot 3 Mill slot
2 Louvered shutter 4 Key punched

5 Gauzed wrapped

8 Saw cut

11 None (open hole)

6 Wire wrapped
7 Torch cut9 Drilled holes
10 Other (specify)

SCREEN-PERFORATED INTERVALS: From 76 ft. to 96 ft., From ft. to ft., From ft. to ft.

From ft. to ft., From ft. to ft., From ft. to ft.

GRAVEL PACK INTERVALS: From 20 ft. to 96 ft., From ft. to ft., From ft. to ft.

From ft. to ft., From ft. to ft.

6 GROUT MATERIAL: 1 Neat cement 2 Cement grout 3 Bentonite 4 Other

Grout Intervals: From 3 ft. to 23 ft., From ft. to ft., From ft. to ft., From ft. to ft.

What is the nearest source of possible contamination:

1 Septic tank 4 Lateral lines
2 Sewer lines 5 Cess pool
3 Watertight sewer lines 6 Seepage pit7 Pit privy
8 Sewage lagoon
9 Feedyard10 Livestock pens
11 Fuel storage14 Abandoned water well
15 Oil well/Gas well
16 Other (specify below)

Direction from well?

Down SLOPE

LITHOLOGIC LOG

FROM TO PLUGGING INTERVALS

0	7	Earth	FROM	TO	PLUGGING INTERVALS
7	10	Rock			
10	20	Red Bed			
20	40	Yellow Brown water			
40	60	Brown Clay			
60	70	Gray shale water			
70	86	Shaly lime			

7 CONTRACTOR'S OR LANDOWNER'S CERTIFICATION: This water well was (1) constructed, (2) reconstructed, or (3) plugged under my jurisdiction and was completed on (mo/day/year) 10/16/1988 and this record is true to the best of my knowledge and belief. Kansas

Water Well Contractor's License No. 493 This Water Well Record was completed on (mo/day/yr) 10/27/88

under the business name of Keri'ser Well Drilling by (signature) Keri'ser Well Drilling

INSTRUCTIONS: Use typewriter or ball point pen. PLEASE PRESS FIRMLY and PRINT clearly. Please fill in blanks, underline or circle the correct answers. Send top three copies to Kansas Department of Health and Environment, Bureau of Water Protection, Topeka, Kansas 66620-7320. Telephone: 913-296-5514. Send one to WATER WELL OWNER and retain one for your records.