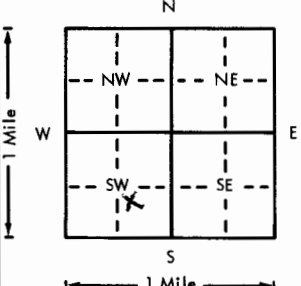


USE TYPEWRITER OR BALL
POINT PEN-PRESS FIRMLY,
PRINT CLEARLY.

WATER WELL RECORD
KSA 82a-1201-1215

Kansas Department of Health and
Environment-Division of Environment
(Water well Contractors)
Topeka, Kansas 66620

| | | | | | | | |
|--|--|-----------------------------------|---|--|--------------------------------|------------------------------|-----------|
| 1. Location of well: | | County <u>Butler</u> | Fraction <u>NW 1/4 SE 1/4 SW 1/4</u> | Section number <u>25</u> | Township number <u>T 26</u> | Range number <u>S R 4</u> | <u>EW</u> |
| 2. Distance and direction from nearest town or city: <u>of Augusta Kans</u> | | | | 3. Owner of well: <u>Larry Schneidewind</u> R.R. or street: <u>Route 1</u> City, state, zip code: <u>Augusta Kans 67010</u> | | | |
| 4. Locate with "X" in section below: | | Sketch map: | | 6. Bore hole dia. <u>4</u> in. Completion date <u>11</u> Well depth <u>120</u> ft. <u>10-17-75</u> | | | |
|  | | <u>not pasture but grassland.</u> | | 7. <input checked="" type="checkbox"/> Cable tool <input type="checkbox"/> Rotary <input type="checkbox"/> Driven <input type="checkbox"/> Dug <input type="checkbox"/> Hollow rod <input type="checkbox"/> Jetted <input type="checkbox"/> Bored <input type="checkbox"/> Reverse rotary | | | |
| 5. Type and color of material | | From To | | 8. Use: <input checked="" type="checkbox"/> Domestic <input type="checkbox"/> Public supply <input type="checkbox"/> Industry <input type="checkbox"/> Irrigation <input type="checkbox"/> Air conditioning <input type="checkbox"/> Stock <input type="checkbox"/> Lawn <input type="checkbox"/> Oil field water <input type="checkbox"/> Other | | | |
| Red Clay | | 0 5 | | 9. Casing: Material <u>PLTS</u> Height <u>Above</u> or below Threaded <input type="checkbox"/> Welded <input checked="" type="checkbox"/> Surface <u>18</u> in. RMP <input checked="" type="checkbox"/> PVC <input type="checkbox"/> Weight <u>18</u> lbs./ft. Dia. <u>6</u> in. to <u>100</u> ft. depth Wall Thickness: inches or Dia. <u>6</u> in. to <u>100</u> ft. depth gage No. <u>175</u> | | | |
| yellow lime | | 5 30 | | 10. Screen: Manufacturer's name <u>Sunflower</u> <u>Plastics pipe line</u> Type <u>RMP</u> Dia. <u>6 in</u> Slot/gauze <u>1/16</u> Length <u>20 ft</u> Set between <u>106</u> ft. and <u>120</u> ft. _____ ft. and _____ ft. Gravel pack? <u>no</u> Size range of material _____ | | | |
| grey lime | | 30 110 | | 11. Static water level: _____ mo./day/yr. <u>35</u> ft. below land surface Date <u>10-17-75</u> | | | |
| Water | | 110 | | 12. Pumping level below land surfaces: _____ ft. after _____ hrs. pumping _____ g.p.m. _____ ft. after _____ hrs. pumping _____ g.p.m. Estimated maximum yield <u>8</u> g.p.m. | | | |
| grey lime | | 110 120 | | 13. Water sample submitted: _____ mo./day/yr. Yes <input checked="" type="checkbox"/> No <input type="checkbox"/> Date _____ | | | |
| | | | | 14. Well head completion: _____ Pitless adapter <u>18</u> inches above grade | | | |
| | | | | 15. Well grouted? <u>yes</u> With: <input checked="" type="checkbox"/> Neat cement <input type="checkbox"/> Bentonite <input type="checkbox"/> Concrete Depth: From <u>0</u> ft. to <u>12</u> ft. | | | |
| | | | | 16. Nearest source of possible contamination: ft. <u>500</u> Direction <u>north</u> Type <u>stock pond</u> Well disinfected upon completion? <input checked="" type="checkbox"/> Yes <input type="checkbox"/> No | | | |
| | | | | 17. Pump: <u>not</u> Not installed Manufacturer's name _____ Model number _____ HP _____ Volts _____ Length of drop pipe _____ ft. capacity _____ g.p.m. Type: <input type="checkbox"/> Submersible <input type="checkbox"/> Turbine <input type="checkbox"/> Jet <input type="checkbox"/> Reciprocating <input type="checkbox"/> Centrifugal <input type="checkbox"/> Other | | | |
| 18. Elevation: | | 19. Remarks: | | 20. Water well contractor's certification: This well was drilled under my jurisdiction and this report is true to the best of my knowledge and belief. <u>Murray White well drilling</u> Business name _____ License No. _____ Address <u>Route 3, Augusta 122</u> Signed <u>Murray White</u> Date <u>10-17-75</u> Authorized representative | | | |