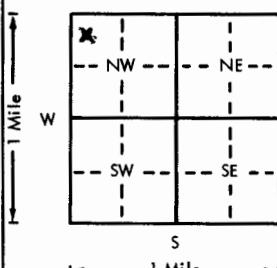
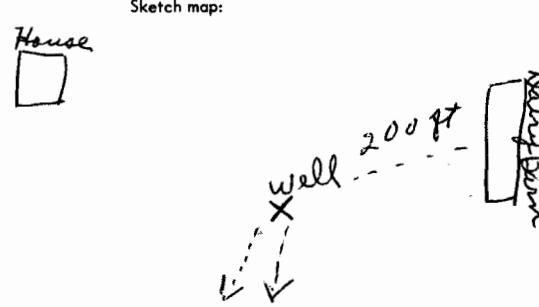


USE TYPEWRITER OR BALL
POINT PEN-PRESS FIRMLY,
PRINT CLEARLY.

WATER WELL RECORD
KSA 82a-1201-1215

Kansas Department of Health and
Environment-Division of Environment
(Water well Contractors)
Topeka, Kansas 66620

1. Location of well:	County <i>Butter</i>	Fraction <i>NE 1/4 NW 1/4 NW 1/4</i>	Section number <i>26</i>	Township number <i>T 26 S</i>	Range number <i>R 4 E</i>
2. Distance and direction from nearest town or city:	<i>1 E 2 1/4 S</i>		3. Owner of well: R.R. or street: <i>R#1</i>	<i>Warren Corbin</i>	
Street address of well location if in city:	<i>Towanda</i>		City, state, zip code: <i>El Dorado</i>		
4. Locate with "X" in section below:			Sketch map: 	6. Bore hole dia. <u>10</u> in. Completion date <u>11-11-1976</u> Well depth <u>135</u> ft.	
				7. <input checked="" type="checkbox"/> Cable tool <input type="checkbox"/> Rotary <input type="checkbox"/> Driven <input type="checkbox"/> Dug <input type="checkbox"/> Hollow rod <input type="checkbox"/> Jetted <input type="checkbox"/> Bored <input type="checkbox"/> Reverse rotary	
				8. Use: <input checked="" type="checkbox"/> Domestic <input type="checkbox"/> Public supply <input type="checkbox"/> Industry <input type="checkbox"/> Irrigation <input type="checkbox"/> Air conditioning <input checked="" type="checkbox"/> Stock <input type="checkbox"/> Lawn <input type="checkbox"/> Oil field water <input type="checkbox"/> Other	
				9. Casing: Material <u>PVC</u> Height: Above or below Threaded <input type="checkbox"/> Welded <u>gl</u> Surface <u>18</u> in. RMP <u>X</u> PVC Weight <u>6</u> lbs./ft. Dia. <u>6</u> in. to <u>135</u> ft. depth Wall Thickness: inches or Dia. <u>6</u> in. to <u>ft.</u> depth gage No. <u>175</u>	
				10. Screen: Manufacturer's name <u>RMP</u> Type <u>RMP</u> Dia. <u>6 in</u> Siz/gauze <u>14</u> Length <u>20</u> Set between <u>108</u> ft. and <u>120</u> ft. ____ ft. and ____ ft. Gravel pack? <u>no</u> Size range of material _____	
				11. Static water level: mo./day/yr. <u>100</u> ft. below land surface Date <u>11-11-1976</u>	
				12. Pumping level below land surfaces: ____ ft. after ____ hrs. pumping ____ g.p.m. ____ ft. after ____ hrs. pumping ____ g.p.m. Estimated maximum yield <u>20+</u> g.p.m.	
				13. Water sample submitted: mo./day/yr. Yes <input checked="" type="checkbox"/> No _____ Date _____	
				14. Well head completion: <input checked="" type="checkbox"/> Pitless adapter <u>18</u> inches above grade	
				15. Well grouted? <u>yes</u> With: <input checked="" type="checkbox"/> Neat cement <input type="checkbox"/> Bentonite <input type="checkbox"/> Concrete Depth: From <u>3</u> ft. to <u>13</u> ft.	
				16. Nearest source of possible contamination: ft. <u>200</u> Direction <u>east</u> Type <u>Mansure</u> Well disinfected upon completion? <input checked="" type="checkbox"/> Yes <input type="checkbox"/> No	
				17. Pump: Not installed Manufacturer's name <u>Hardy</u> Model number <u>25EL</u> HP <u>1/2</u> Volts <u>230</u> Length of drop pipe <u>125</u> ft. capacity <u>20</u> g.p.m. Type: <input checked="" type="checkbox"/> Submersible <input type="checkbox"/> Turbine <input type="checkbox"/> Jet <input type="checkbox"/> Reciprocating <input type="checkbox"/> Centrifugal <input type="checkbox"/> Other	
				18. Elevation: Topography: <input type="checkbox"/> Hill <input type="checkbox"/> Slope <input checked="" type="checkbox"/> Upland <input type="checkbox"/> Valley	19. Remarks: <i>owner will put on slab</i> <i>Warren W. Corbin</i>
				20. Water well contractor's certification: This well was drilled under my jurisdiction and this report is true to the best of my knowledge and belief. <i>Mike Well Drilling 122</i> Business name <u>R#3</u> License No. <u>Augusta Kansas 67010</u> Address <u>Sperry 1000</u> Date <u>11-11-76</u> Signed <u>Warren W. Corbin</u> Authorized representative	