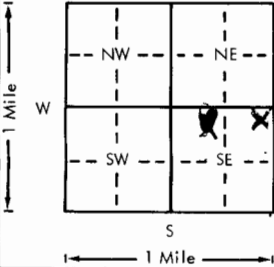
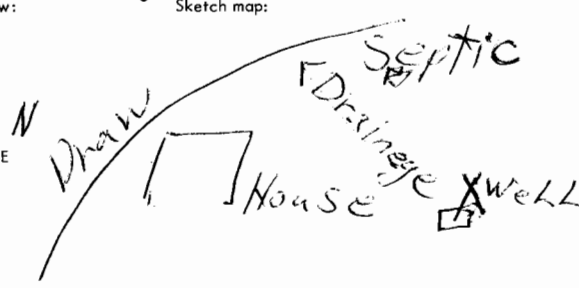


USE TYPEWRITER OR BALL
POINT PEN-PRESS FIRMLY,
PRINT CLEARLY.

WATER WELL RECORD
KSA 82a-1201-1215

Kansas Department of Health and
Environment-Division of Environment
(Water well Contractors)
Topeka, Kansas 66620

1. Location of well:		County: <u>Butler</u>	Fraction: <u>NE 1/4 NE 1/4 SE 1/4</u>	Section number: <u>30</u>	Township number: <u>T 26 S</u>	Range number: <u>R 4 E/W</u>
2. Distance and direction from nearest town or city: <u>4 1/2 5 N</u> Street address of well location if in city: <u>Augusta</u>				3. Owner of well: <u>Bob Barch</u> R.R. or street: <u>R 2 Towanda</u> City, state, zip code:		
<input checked="" type="checkbox"/> Locate with "X" in section below: 		Sketch map: 		6. Bore hole dia. <u>3</u> in. Completion date <u>7/3/78</u> Well depth <u>70</u> ft.		
5. Type and color of material		From		To		7. <input checked="" type="checkbox"/> Cable tool <input type="checkbox"/> Rotary <input type="checkbox"/> Driven <input type="checkbox"/> Dug <input type="checkbox"/> Hollow rod <input type="checkbox"/> Jetted <input type="checkbox"/> Bored <input type="checkbox"/> Reverse rotary
						8. Use: <input checked="" type="checkbox"/> Domestic <input type="checkbox"/> Public supply <input type="checkbox"/> Industry <input type="checkbox"/> Irrigation <input type="checkbox"/> Air conditioning <input type="checkbox"/> Stock <input type="checkbox"/> Lawn <input type="checkbox"/> Oil field water <input type="checkbox"/> Other
						9. Casing: Material <u>Plastic</u> Height: Above or below Threaded <input type="checkbox"/> Welded <input checked="" type="checkbox"/> Surface <u>15</u> in. RMP <input type="checkbox"/> PVC <input checked="" type="checkbox"/> Weight <u>100</u> lbs./ft. Dia. <u>6</u> in. to <u>70</u> ft. depth Wall Thickness: inches or Dia. <input type="checkbox"/> in. to <input type="checkbox"/> ft. depth gage No. <u>115</u>
						10. Screen: Manufacturer's name <u>SunFlow</u> Type <u>100</u> Dia. <u>6</u> Slot/gauze <u>1/32</u> Length <u>20</u> Set between <u>130</u> ft. and <u>70</u> ft. <input type="checkbox"/> ft. and <input type="checkbox"/> ft. Gravel pack? <u>no</u> Size range of material
						11. Static water level: <u>50</u> ft. below land surface Date <u>7/30/78</u> mo./day/yr.
(Use a second sheet if needed)						12. Pumping level below land surfaces: <u>50</u> ft. after <u>1</u> hrs. pumping <u>50</u> g.p.m. <input type="checkbox"/> ft. after <input type="checkbox"/> hrs. pumping <input type="checkbox"/> g.p.m. Estimated maximum yield <u>50</u> g.p.m.
						13. Water sample submitted: <input type="checkbox"/> Yes <input checked="" type="checkbox"/> No Date
						14. Well head completion: <input checked="" type="checkbox"/> Pitless adapter <u>15</u> inches above grade <input checked="" type="checkbox"/> Well grouted? <u>yes</u> With: <input checked="" type="checkbox"/> Neat cement <input type="checkbox"/> Bentonite <input type="checkbox"/> Concrete Depth: From <u>0</u> ft. to <u>70</u> ft.
						16. Nearest source of possible contamination: ft. <u>200</u> Direction <u>SE</u> Type <u>septic</u> Well disinfected upon completion? <input checked="" type="checkbox"/> Yes <input type="checkbox"/> No
						17. Pump: <input type="checkbox"/> Not installed Manufacturer's name <u>Goalco</u> Model number <u>HP</u> Volts <u>230</u> Length of drop pipe <u>55</u> ft. capacity <u>15</u> g.p.m. Type: <input checked="" type="checkbox"/> Submersible <input type="checkbox"/> Turbine <input type="checkbox"/> Jet <input type="checkbox"/> Reciprocating <input type="checkbox"/> Centrifugal <input type="checkbox"/> Other
18. Elevation:	19. Remarks: <u>Owner To Install</u> <u>Concrete slab around water well</u> <u>Well</u>		20. Water well contractor's certification: This well was drilled under my jurisdiction and this report is true to the best of my knowledge and belief. Business name <u>251A</u> License No. <u>251A</u> Address <u>R 2 Box 30 Augusta</u> Signed <u>Charles W. Wanda</u> Date <u>7/5/78</u> Authorized representative			