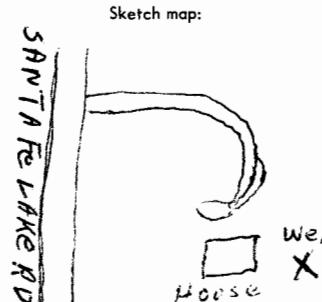


1. Location of well:	County	Fraction	Section number	Township number	Range number
	BUTLER	SW 1/4 NW 1/4 SW 1/4	30	T 26 (S)	R 4 (E)
2. Distance and direction from nearest town or city: Street address of well location if in city:	3 mi west of TAWANDA, KAN on 254th & 3 MIL SOUTH on SANTA FE LAKE RD		3. Owner of well: R.R. or street: City, state, zip code:	Bob LANE 902 South Sheldon EL DORADO, KANSAS 67042	
4. Locate with "X" in section below:	Sketch map: 		6. Bore hole dia. <u>10</u> in. Completion date <u>11-16-78</u> Well depth <u>99</u> ft.		
			7. <input checked="" type="checkbox"/> Cable tool <input type="checkbox"/> Rotary <input type="checkbox"/> Driven <input type="checkbox"/> Dug <input type="checkbox"/> Hollow rod <input type="checkbox"/> Jetted <input type="checkbox"/> Bored <input type="checkbox"/> Reverse rotary		
			8. Use: <input checked="" type="checkbox"/> Domestic <input type="checkbox"/> Public supply <input type="checkbox"/> Industry <input type="checkbox"/> Irrigation <input type="checkbox"/> Air conditioning <input type="checkbox"/> Stock <input type="checkbox"/> Lawn <input type="checkbox"/> Oil field water <input type="checkbox"/> Other		
			9. Casing: Material <input type="checkbox"/> Threaded <input type="checkbox"/> Welded <input type="checkbox"/> Surface <u>36</u> in. RMP <input type="checkbox"/> PVC <input checked="" type="checkbox"/> Weight <u>10</u> lbs./ft. Dia. <u>5</u> in. to <u>99</u> ft. depth Wall Thickness: inches or Dia. <u>5</u> in. to <u>99</u> ft. depth gage No. <u>258</u>		
5. Type and color of material		From	To	10. Screen: Manufacturer's name <u>ASTM</u> Type <u>500 ft</u> Dia. <u>5 1/4</u> Slot/gauze <u>0.25</u> Length <u>100</u> Set between <u>89</u> ft. and <u>99</u> ft. ft. and <u>99</u> ft. Gravel pack? <input checked="" type="checkbox"/> Size range of material <u>75-100</u>	
Topsoil		1	2		
Red Clay		2	10		
Lime Rock		10	25	11. Static water level: mo./day/yr. <u>32</u> ft. below land surface Date <u>11-16-78</u>	
Shale grayish		25	50	12. Pumping level below land surfaces: ft. after <u>hrs.</u> pumping g.p.m. ft. after <u>hrs.</u> pumping g.p.m. Estimated maximum yield g.p.m.	
Sand Redish		50	70		
Shale Red		70	80	13. Water sample submitted: mo./day/yr. Yes <input checked="" type="checkbox"/> No <input type="checkbox"/> Date	
gravel - v to c.		80	81	14. Well head completion: <input checked="" type="checkbox"/> Pitless adapter <u>36</u> inches above grade	
Shale grayish		81	99	15. Well grouted? <input checked="" type="checkbox"/> With: <input type="checkbox"/> Neat cement <input type="checkbox"/> Bentonite <input checked="" type="checkbox"/> Concrete Depth: From <u>3</u> ft. to <u>13</u> ft.	
(Use a second sheet if needed)				16. Nearest source of possible contamination: ft. <u>1000</u> Direction <u>N</u> Type <u>Agro</u> Well disinfected upon completion? <input checked="" type="checkbox"/> Yes <input type="checkbox"/> No	
18. Elevation:	19. Remarks:			17. Pump: <input checked="" type="checkbox"/> Not installed Manufacturer's name _____ Model number _____ HP _____ Volts _____ Length of drop pipe _____ ft. capacity _____ g.p.m. Type: <input type="checkbox"/> Submersible <input type="checkbox"/> Turbine <input type="checkbox"/> Jet <input type="checkbox"/> Reciprocating <input type="checkbox"/> Centrifugal <input type="checkbox"/> Other	
Topography: <input type="checkbox"/> Hill <input checked="" type="checkbox"/> Slope <input type="checkbox"/> Upland <input type="checkbox"/> Valley					20. Water well contractor's certification: This well was drilled under my jurisdiction and this report is true to the best of my knowledge and belief. <u>B&J Drilling 335</u> Business name <u>B&J EP Drilling Co.</u> License No. <u>12-211</u> Address <u>1212 1/2 E 2nd</u> Signed <u>Bart Hogan</u> Date <u>12-21-78</u> Authorized representative