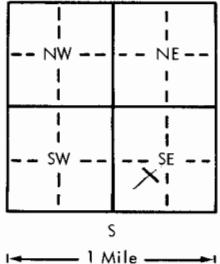
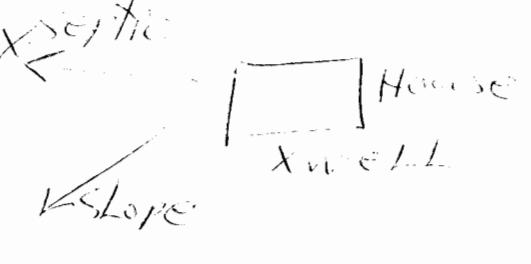


1. Location of well:	County <b>Bath</b>	Fraction <b>NE 1/4 NW 1/4 SE 1/4</b>	Section number <b>30</b>	Township number <b>26</b>	Range number <b>4</b>
2. Distance and direction from nearest town or city:	<b>SW 6N</b>		3. Owner of well:	<b>LeRoy McDonald</b>	
Street address of well location if in city:	<b>of Augusta</b>		R.R. or street:	<b>RI Benton</b>	
4. Locate with "X" in section below:	Sketch map:		6. Bore hole dia. <b>7</b> in. Completion date <b>3/25</b> Well depth <b>100</b> ft.		
			7. <input checked="" type="checkbox"/> Cable tool <input type="checkbox"/> Rotary <input type="checkbox"/> Driven <input type="checkbox"/> Dug <input type="checkbox"/> Hollow rod <input type="checkbox"/> Jetted <input type="checkbox"/> Bored <input type="checkbox"/> Reverse rotary		
5. Type and color of material	From	To	8. Use: <input checked="" type="checkbox"/> Domestic <input type="checkbox"/> Public supply <input type="checkbox"/> Industry <input type="checkbox"/> Irrigation <input type="checkbox"/> Air conditioning <input type="checkbox"/> Stock <input type="checkbox"/> Lawn <input type="checkbox"/> Oil field water <input type="checkbox"/> Other		
<b>Soil</b>	<b>0</b>	<b>5</b>	9. Casing: Material <b>PVC</b> Height: Above or below Threaded <input type="checkbox"/> Welded <b>SL</b> Surface <b>15</b> in. RMP <b>100</b> PVC Weight <b>100</b> lbs./ft. Dia. <b>5</b> in. to <b>10</b> ft. depth Wall Thickness: inches or Dia. <b>5</b> in. to <b>10</b> ft. depth gage No. <b>175</b>		
<b>pearse rock</b>	<b>5</b>	<b>20</b>	10. Screen: Manufacturer's name <b>SUNTON</b>		
<b>Clay</b>	<b>20</b>	<b>35</b>	Type <b>100</b> Dia. <b>5</b> Slot/gauze <b>16</b> Length <b>20</b> Set between <b>65</b> ft. and <b>85</b> ft. <input checked="" type="checkbox"/> ft. and <b>85</b> ft. Gravel pack? <input checked="" type="checkbox"/> Size range of material <b>5/8</b>		
<b>Shale</b>	<b>35</b>	<b>60</b>	11. Static water level: <b>5</b> ft. below land surface Date <b>3/28/71</b>		
<b>Lime</b>	<b>60</b>	<b>80</b>	12. Pumping level below land surfaces: <b>55</b> ft. after <b>1</b> hrs. pumping <b>g.p.m.</b> <b>55</b> ft. after <b>1</b> hrs. pumping <b>g.p.m.</b> Estimated maximum yield <b>30</b> g.p.m.		
<b>Shale</b>	<b>80</b>	<b>90</b>	13. Water sample submitted: <b>mo./day/yr.</b> Yes <input checked="" type="checkbox"/> No <input type="checkbox"/> Date <b> </b>		
			14. Well head completion: Pitless adapter <b> </b> Inches above grade <b> </b>		
			15. Well grouted? <input checked="" type="checkbox"/> With: <input checked="" type="checkbox"/> Neat cement <input type="checkbox"/> Bentonite <input type="checkbox"/> Concrete Depth: From <b> </b> ft. to <b>10</b> ft.		
			16. Nearest source of possible contamination: ft. <b>150</b> Direction <b>W</b> Type <b>Septic</b> Well disinfected upon completion? <input checked="" type="checkbox"/> Yes <input type="checkbox"/> No		
			17. Pump: <input checked="" type="checkbox"/> Not installed Manufacturer's name <b> </b> Model number <b> </b> HP <b> </b> Volts <b> </b> Length of drop pipe <b> </b> ft. capacity <b> </b> g.p.m. Type: <input type="checkbox"/> Submersible <b> </b> Turbine <b> </b> <input type="checkbox"/> Jet <b> </b> Reciprocating <b> </b> <input type="checkbox"/> Centrifugal <b> </b> Other <b> </b>		
(Use a second sheet if needed)			18. Elevation: Topography: <input type="checkbox"/> Hill <input type="checkbox"/> Slope <input checked="" type="checkbox"/> Upland <input type="checkbox"/> Valley		
19. Remarks: <b>Outer To Install Concrete Slab around Well Head</b>			20. Water well contractor's certification: This well was drilled under my jurisdiction and this report is true to the best of my knowledge and belief. <b>Water Well Drill 25/4</b> Business name <b> </b> License No. <b> </b> Address <b>102 Box 30 Augusta</b> Signed <b> </b> Date <b>5/5</b> Authorized representative <b> </b>		