

1 LOCATION OF WATER WELL:

Fraction

NE $\frac{1}{4}$ NW $\frac{1}{4}$ SW $\frac{1}{4}$

Section Number

35

Township Number

T 26 S

Range Number

R 4 ENE

County: **Butler** Distance and direction from nearest town or city street address of well if located within city?

2 1/2 N of Augusta

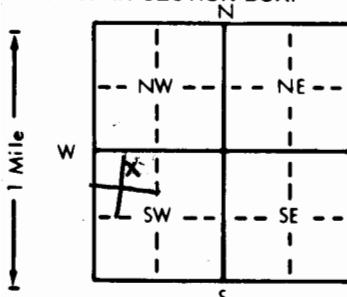
2 WATER WELL OWNER: **Larry Traini**RR#, St. Address, Box # : **522 W 7TH**

Board of Agriculture, Division of Water Resources

City, State, ZIP Code : **Augusta KS 67010**

Application Number:

3 LOCATE WELL'S LOCATION WITH AN "X" IN SECTION BOX:

4 DEPTH OF COMPLETED WELL: **56**ft. ELEVATION: **H-44**Depth(s) Groundwater Encountered 1. **40** ft. 2. ft. 3. ft.WELL'S STATIC WATER LEVEL **38** ft. below land surface measured on mo/day/yr **10-23-82**

Pump test data: Well water was ft. after hours pumping gpm

Est. Yield gpm: Well water was ft. after hours pumping gpm

Bore Hole Diameter **8** in. to ft. and in. to ft.

WELL WATER TO BE USED AS: 5 Public water supply 8 Air conditioning 11 Injection well

1 Domestic 3 Feedlot 6 Oil field water supply 9 Dewatering 12 Other (Specify below)

2 Irrigation 4 Industrial 7 Lawn and garden only 10 Observation well

Was a chemical/bacteriological sample submitted to Department? Yes No If yes, mo/day/yr sample was submittedWater Well Disinfected? Yes No

5 TYPE OF BLANK CASING USED:

1 Steel 3 RMP (SR)
2 PVC 4 ABS

5 Wrought iron

8 Concrete tile

CASING JOINTS: Glued Clamped

6 Asbestos-Cement

9 Other (specify below)

Welded

7 Fiberglass

Threaded Blank casing diameter **5** in. to **36** ft., Dia. in. to ft., Dia. in. to ft.Casing height above land surface **24** in., weight**7 PVC**

10 Asbestos-cement

lbs./ft. Wall thickness or gauge No. **160/16**

TYPE OF SCREEN OR PERFORATION MATERIAL:

1 Steel 3 Stainless steel
2 Brass 4 Galvanized steel

5 Fiberglass

8 RMP (SR)

11 Other (specify)

6 Concrete tile

9 ABS

12 None used (open hole)

SCREEN OR PERFORATION OPENINGS ARE:

1 Continuous slot 3 Mill slot
2 Louvered shutter 4 Key punched

5 Gauzed wrapped

6 Wire wrapped

11 None (open hole)

7 Torch cut

8 Saw cut

9 Drilled holes

10 Other (specify)

SCREEN-PERFORATED INTERVALS: From **36** ft. to **56** ft., From ft. to ft., From ft. to ft.

From ft. to ft., From ft. to ft., From ft. to ft.

GRAVEL PACK INTERVALS: From **56** ft. to **13** ft., From ft. to ft., From ft. to ft.

From ft. to ft., From ft. to ft., From ft. to ft.

6 GROUT MATERIAL: 1 Neat cement **2** Cement grout 3 Bentonite 4 OtherGrout Intervals: From **13** ft. to **3** ft., From ft. to ft., From ft. to ft., From ft. to ft.What is the nearest source of possible contamination: **OPEN Field**

10 Livestock pens

14 Abandoned water well

11 Fuel storage 15 Oil well/Gas well

12 Fertilizer storage 16 Other (specify below)

13 Insecticide storage

How many feet?

Direction from well?

FROM TO LITHOLOGIC LOG

0 1 Top Soil

1 3 Clay Reddish brown

3 11 Limestone yellow

11 17 Shale yellow

17 23 Shale Rusty Red

23 31 Shale Light gray

31 39 Shale Rusty Red

39 55 Limestone yellow

7 CONTRACTOR'S OR LANDOWNER'S CERTIFICATION: This water well was **1** constructed, (2) reconstructed, or (3) plugged under my jurisdiction and was completed on (mo/day/year) **10-23-82** and this record is true to the best of my knowledge and belief. KansasWater Well Contractor's License No. **363** This Water Well Record was completed on (mo/day/yr) **10-25-82**under the business name of **Braddy Water Wells** by (signature) **Richard Braddy**

INSTRUCTIONS: Use typewriter or ball point pen, PLEASE PRESS FIRMLY and PRINT clearly. Please fill in blanks, underline or circle the correct answers. Send top three copies to Kansas Department of Health and Environment, Division of Environment, Environmental Geology Section, Topeka, KS 66620. Send one to WATER WELL OWNER and retain one for your records.