

## WATER WELL RECORD Form WWC-5 KSA 82a-1212

1 LOCATION OF WATER WELL:

Fraction:


Section Number:

Township Number:

Range Number:

County: Butler  
Distance and direction from nearest town or city street address of well if located within city?10 5 N East of Augusta  
2 WATER WELL OWNER: Janet Fanning Eldorado Kan  
RR#, St. Address, Box #: 218 Warren Rd 67042 Board of Agriculture, Division of Water Resources  
City, State, ZIP Code: Application Number:

3 LOCATE WELL'S LOCATION WITH AN "X" IN SECTION BOX:

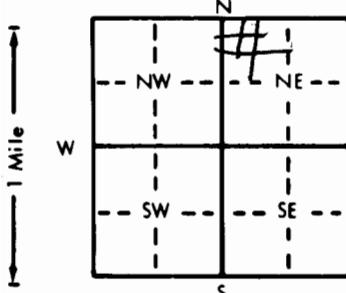

4 DEPTH OF COMPLETED WELL: 145 ft. ELEVATION:

Depth(s) Groundwater Encountered 1. 95 ft. 2. ft. 3. ft.

WELL'S STATIC WATER LEVEL 30 ft. below land surface measured on mo/day/yr

Pump test data: Well water was ft. after hours pumping gpm

Est. Yield 30 gpm: Well water was ft. after hours pumping gpm

Bore Hole Diameter 8 in. to ft. and in. to ft.

WELL WATER TO BE USED AS: 5 Public water supply 8 Air conditioning 11 Injection well

1 Domestic 3 Feedlot 6 Oil field water supply 9 Dewatering 12 Other (Specify below)

2 Irrigation 4 Industrial 7 Lawn and garden only 10 Observation well

Was a chemical/bacteriological sample submitted to Department? Yes No If yes, mo/day/yr sample was submitted

Water Well Disinfected? Yes No

5 TYPE OF BLANK CASING USED:

1 Steel 3 RMP (SR)  
2 PVC 4 ABS

5 Wrought iron

8 Concrete tile

CASING JOINTS: Glued X Clamped

6 Asbestos-Cement

9 Other (specify below)

Welded

7 Fiberglass

Threaded

Blank casing diameter 5 in. to 70 ft., Dia. in. to ft., Dia. in. to ft.

Casing height above land surface 18 in., weight 200 lbs./ft. Wall thickness or gauge No. 1214

TYPE OF SCREEN OR PERFORATION MATERIAL:

1 Steel 3 Stainless steel  
2 Brass 4 Galvanized steel

5 Fiberglass

7 PVC

10 Asbestos-cement

6 Concrete tile

8 RMP (SR)

11 Other (specify)

7 Gauzed wrapped

9 ABS

12 None used (open hole)

6 Wire wrapped

10 Other (specify)

8 Saw cut

11 None (open hole)

7 Torch cut

9 Drilled holes

SCREEN OR PERFORATION OPENINGS ARE:

1 Continuous slot 3 Mill slot  
2 Louvered shutter 4 Key punched

10 Livestock pens

14 Abandoned water well

SCREEN-PERFORATED INTERVALS: From 70 ft. to 145 ft., From ft. to ft., From ft. to ft.

GRAVEL PACK INTERVALS: From ft. to ft., From ft. to ft., From ft. to ft.

From ft. to ft., From ft. to ft., From ft. to ft.

6 GROUT MATERIAL: 1 Neat cement 2 Cement grout 3 Bentonite 4 Other

Grout Intervals: From 0 ft. to 20 ft., From ft. to ft., From ft. to ft., From ft. to ft.

What is the nearest source of possible contamination:

1 Septic tank 4 Lateral lines 7 Pit privy  
2 Sewer lines 5 Cess pool 8 Sewage lagoon  
3 Watertight sewer lines 6 Seepage pit 9 Feedyard

10 Livestock pens

15 Oil well/Gas well

11 Fuel storage

16 Other (specify below)

12 Fertilizer storage

13 Insecticide storage

How many feet? 200

Direction from well? S E

FROM TO LITHOLOGIC LOG FROM TO LITHOLOGIC LOG

FROM	TO	LITHOLOGIC LOG	FROM	TO	LITHOLOGIC LOG
0	1	Soil			
1	6	Rock			
6	10	Clay			
10	35	Shale			
35	145	Shale & Lime			