

WATER WELL RECORD Form WWC-5 KSA 82a-1212

1 LOCATION OF WATER WELL:	Fraction	Section Number	Township Number	Range Number
County: BUTLER	NW $\frac{1}{4}$ SE $\frac{1}{4}$ SE $\frac{1}{4}$	36	T 26 S	R 4 EW


Distance and direction from nearest town or city street address of well if located within city?

MW-5

2 WATER WELL OWNER: **Mobil Refining**
 RR#, St. Address, Box #: **P.O. Box 874**
 City, State, ZIP Code: **Soliet, IN 60434**

Board of Agriculture, Division of Water Resources
 Application Number:

3 LOCATE WELL'S LOCATION WITH AN "X" IN SECTION BOX:

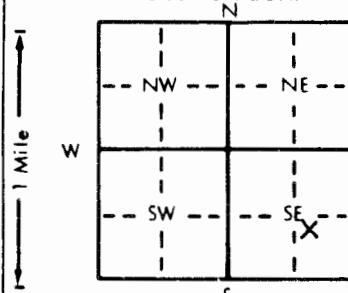

4 DEPTH OF COMPLETED WELL: **21** ft. ELEVATION: **12.5**
 Depth(s) Groundwater Encountered **12.5** ft. 2. ft. 3. ft.
 WELL'S STATIC WATER LEVEL **12.5** ft. below land surface measured on mo/day/yr
 Pump test data: Well water was ft. after hours pumping gpm
 Est. Yield gpm Well water was ft. after hours pumping gpm
 Bore Hole Diameter **6** in. to **21.5** ft. and in. to ft.
 WELL WATER TO BE USED AS: 5 Public water supply 8 Air conditioning 11 Injection well
 1 Domestic 3 Feedlot 6 Oil field water supply 9 Dewatering 12 Other (Specify below)
 2 Irrigation 4 Industrial 7 Lawn and garden only **10** Monitoring well
 Was a chemical/bacteriological sample submitted to Department? Yes **X** No ; If yes, mo/day/yr sample was submitted
 Water Well Disinfected? Yes No

5 TYPE OF BLANK CASING USED:

1 Steel	3 RMP (SR)	5 Wrought iron	8 Concrete tile	CASING JOINTS: Glued	Clamped
2 PVC	4 ABS	6 Asbestos-Cement	9 Other (specify below)	Welded	X
Blank casing diameter 2 in. to 6 ft., Dia .69 in. to ft., Dia			in. to ft., Dia in. to ft.		

Casing height above land surface **24** in., weight **.69** lbs./ft. Wall thickness or gauge No. **7 PVC**

TYPE OF SCREEN OR PERFORATION MATERIAL:

1 Steel	3 Stainless steel	5 Fiberglass	8 RMP (SR)	10 Asbestos-cement
2 Brass	4 Galvanized steel	6 Concrete tile	9 ABS	11 Other (specify)

SCREEN OR PERFORATION OPENINGS ARE:

1 Continuous slot	3 Mill slot	5 Gauzed wrapped	8 Saw cut	11 None (open hole)
2 Louvered shutter	4 Key punched	6 Wire wrapped	9 Drilled holes	10 Other (specify)

SCREEN-PERFORATED INTERVALS: From **6** ft. to **21** ft., From **6** ft. to **21** ft., From **6** ft. to **21** ft.

GRAVEL PACK INTERVALS: From **4** ft. to **21** ft., From **4** ft. to **21** ft., From **4** ft. to **21** ft.

6 GROUT MATERIAL: **1** Neat cement **2** Cement grout **3** Bentonite **4** Other

Grout Intervals: From **0** ft. to **2** ft., From **0** ft. to **4** ft., From **0** ft. to **5** ft.

What is the nearest source of possible contamination:

1 Septic tank	4 Lateral lines	7 Pit privy	10 Livestock pens	14 Abandoned water well
2 Sewer lines	5 Cess pool	8 Sewage lagoon	11 Fuel storage	15 Oil well/Gas well
3 Watertight sewer lines	6 Seepage pit	9 Feedyard	12 Fertilizer storage	16 Other (specify below)

Direction from well? **Unknown** How many feet? **500'**

FROM	TO	LITHOLOGIC LOG	FROM	TO	PLUGGING INTERVALS
0	4.5	Clayey sand			
4.5	19.5	Ls - lt gray			
19.5	21.5	Ls - gray			

7 CONTRACTOR'S OR LANDOWNER'S CERTIFICATION: This water well was **1** constructed, **2** reconstructed, or **3** plugged under my jurisdiction and was completed on (mo/day/year) **10/28/94** and this record is true to the best of my knowledge and belief. Kansas Water Well Contractor's License No. **581** This Water Well Record was completed on (mo/day/year) **10/15/94** by (signature) **Shawn D. Mitchell**

INSTRUCTIONS: Use typewriter or ball point pen. PLEASE PRESS FIRMLY and PRINT clearly. Please fill in blanks, underline or circle the correct answers. Send top three copies to Kansas Department of Health and Environment, Bureau of Water, Topeka, Kansas 66620-0001. Telephone: 913-296-5545. Send one to WATER WELL OWNER and retain one for your records.