


1 LOCATION OF WATER WELL: County: <u>Butler</u>		Fraction <u>NW</u> $\frac{1}{4}$ <u>SW</u> $\frac{1}{4}$ <u>NN</u> $\frac{1}{4}$	Section Number <u>28</u>	Township Number T <u>26</u> S	Range Number R <u>5</u> <u>EW</u>
--	--	---	-----------------------------	----------------------------------	--------------------------------------

Distance and direction from nearest town or city street address of well if located within city?
Approx 4 1/2 mi. South of El Dorado, Ks.

2 WATER WELL OWNER: Butler County
RR#, St. Address, Box # : 205 W. Central
City, State, ZIP Code El Dorado KS. 67042

Board of Agriculture, Division of Water Resources
Application Number:

3 LOCATE WELL'S LOCATION WITH AN "X" IN SECTION BOX: 4 DEPTH OF COMPLETED WELL: 18 ft. ELEVATION: 14 ft. 2 ft. 3 ft.

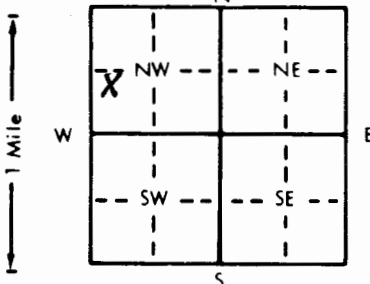

4 DEPTH OF COMPLETED WELL. 13 ft. ELEVATION: _____
 Depth(s) Groundwater Encountered 1. 14 ft. 2. _____ ft. 3. _____ ft.
 WELL'S STATIC WATER LEVEL 0 ft. below land surface measured on mo/day/yr _____
 Pump test data: Well water was _____ ft. after _____ hours pumping _____ gpm
 Est. Yield _____ gpm: Well water was _____ ft. after _____ hours pumping _____ gpm
 Bore Hole Diameter 8 1/4 in. to _____ ft., and _____ in. to _____ ft.
 WELL WATER TO BE USED AS:
 1 Domestic 3 Feedlot 6 Oil field water supply 9 Dewatering 12 Other (Specify below)
 2 Irrigation 4 Industrial 7 Lawn and garden only ⑩ Monitoring well Piezometer
 Was a chemical/bacteriological sample submitted to Department? Yes _____ No X; If yes, mo/day/yr sample was sub-
 mitted _____ Water Well Disinfected? Yes _____ No X

5 TYPE OF BLANK CASING USED:		5 Wrought iron	8 Concrete tile	CASING JOINTS: Glued Clamped	
1 Steel	3 RMP (SR)	6 Asbestos-Cement	9 Other (specify below)	Welded	
2 PVC	4 ABS	7 Fiberglass		Threaded	
Blank casing diameter 2" in. to 8' ft., Dia	 in. to ft., Dia	 in. to ft.	
Casing height above land surface 1' 8" in.		weight lbs./ft.		Wall thickness or gauge No.	

TYPE OF SCREEN OR PERFORATION MATERIAL:			7 PVC	10 Asbestos-cement
1 Steel	3 Stainless steel	5 Fiberglass	8 RMP (SR)	11 Other (specify)
2 Brass	4 Galvanized steel	6 Concrete tile	9 ABS	12 None used (open hole)

SCREEN OR PERFORATION OPENINGS ARE:

1 Continuous slot	<u>3</u> Mill slot	5 Gauzed wrapped	8 Saw cut	11 None (open hole)
2 Louvered shutter	4 Key punched	6 Wire wrapped	9 Drilled holes	<u>010</u>
		7 Torch cut	10 Other (specify)	

SCREEN-PERFORATED INTERVALS:	From	13	ft. to	2	ft. From		ft. to		ft.
	From		ft. to		ft. From		ft. to		ft.
GRAVEL PACK INTERVALS:	From	13	ft. to	6	ft. From		ft. to		ft.
	From		ft. to		ft. From		ft. to		ft.

8. GROUT MATERIAL: 1 Neat cement 2 Cement grout 3 Bentonite 4 Other
Grout Intervals: From 6 ft. to 3 ft. From ft. to ft. From ft. to ft.

What is the nearest source of possible contamination:

1 Septic tank	4 Lateral lines	7 Pit privy	10 Livestock pens	14 Abandoned water well
2 Sewer lines	5 Cess pool	8 Sewage lagoon	11 Fuel storage	15 Oil well/Gas well
3 Watertight sewer lines	6 Seepage pit	9 Feedyard	12 Fertilizer storage	16 Other (specify below)
			13 Insecticide storage	LANDFILL

Direction from well?

Direction from well?		LITHOLOGIC LOG	How many feet?		PLUGGING INTERVALS
FROM	TO		FROM	TO	

[illegible]

CONTRACTOR'S OR LANDOWNER'S CERTIFICATION: This water well was (1) constructed, (2) reconstructed, or (3) plugged under my jurisdiction and was completed on (mo/day/year) 7-10-95 and this record is true to the best of my knowledge and belief. Kansas Water Well Contractor's License No. 568 This Water Well Record was completed on (mo/day/yr) 7-10-95 under the business name of MAX'S Enterprises by (signature) David Hargrave