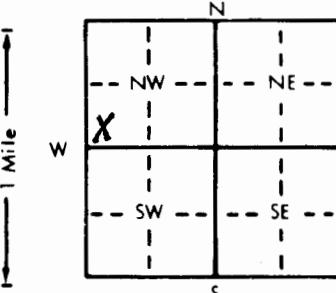


WATER WELL RECORD Form WWC-5 KSA 82a-1212

1 LOCATION OF WATER WELL: County: Butter	Fraction SW 1/4 SW 1/4 NW 1/4	Section Number 28	Township Number T 26 S	Range Number R 3 E
Distance and direction from nearest town or city, street address or well if located within city? APPROX 4 1/2 mi. South of Eldorado, KS.				
2 WATER WELL OWNER: RR#, St. Address, Box # 205 W. Central	Board of Agriculture, Division of Water Resources Application Number:			
3 LOCATE WELL'S LOCATION WITH AN "X" IN SECTION BOX: 	4 DEPTH OF COMPLETED WELL 14'	ft. ELEVATION: 8'		
Depth(s) Groundwater Encountered 1. 8' ft. 2. ft. 3. ft.				
WELL'S STATIC WATER LEVEL ft. below land surface measured on mo/day/yr				
Pump test data: Well water was ft. after hours pumping gpm				
Est. Yield gpm: Well water was ft. after hours pumping gpm				
Bore Hole Diameter 8 ft. in. to ft. and in. to ft.				
WELL WATER TO BE USED AS: 5 Public water supply 8 Air conditioning 11 Injection well 1 Domestic 3 Feedlot 6 Oil field water supply 9 Dewatering 2 Irrigation 4 Industrial 7 Lawn and garden only 10 Monitoring well Piezometer 12 Other (Specify below)				
Was a chemical/bacteriological sample submitted to Department? Yes <input checked="" type="checkbox"/> No <input checked="" type="checkbox"/> If yes, mo/day/yr sample was submitted				
Water Well Disinfected? Yes <input checked="" type="checkbox"/> No <input checked="" type="checkbox"/>				
5 TYPE OF BLANK CASING USED: 1 Steel 3 RMP (SR) 2 PVC 4 ABS	5 Wrought iron 6 Asbestos-Cement 7 PVC	8 Concrete tile 9 Other (specify below)	CASING JOINTS: Glued <input checked="" type="checkbox"/> Clamped <input checked="" type="checkbox"/> Welded <input checked="" type="checkbox"/> Threaded <input checked="" type="checkbox"/>	
Blank casing diameter 2 1/2" in. to 4" ft., Dia in. to ft., Dia in. to ft.	lbs./ft. Wall thickness or gauge No.			
Casing height above land surface 16" in., weight				
TYPE OF SCREEN OR PERFORATION MATERIAL: 1 Steel 3 Stainless steel 5 Fiberglass 2 Brass 4 Galvanized steel 6 Concrete tile	7 Gauzed wrapped 8 RMP (SR) 9 ABS	10 Asbestos-cement 11 Other (specify) 12 None used (open hole)		
SCREEN OR PERFORATION OPENINGS ARE: 1 Continuous slot 3 Mill slot 2 Louvered shutter 4 Key punched	5 Wire wrapped 6 Torch cut	7 Saw cut 9 Drilled holes 10 Other (specify) 0.0	11 None (open hole)	
SCREEN-PERFORATED INTERVALS: From 14' ft. to ft., From ft. to ft., From ft. to ft., From ft. to ft.				
GRAVEL PACK INTERVALS: From ft. to ft., From ft. to ft., From ft. to ft.				
6 GROUT MATERIAL: 1 Neat cement 2 Cement grout 3 Bentonite 4 Other				
Grout Intervals: From 3 ft. to 2 ft., From ft. to ft., From ft. to ft., From ft. to ft.				
What is the nearest source of possible contamination: 1 Septic tank 4 Lateral lines 7 Pit privy 10 Livestock pens 14 Abandoned water well 2 Sewer lines 5 Cess pool 8 Sewage lagoon 11 Fuel storage 15 Oil well/Gas well 3 Watertight sewer lines 6 Seepage pit 9 Feedyard 12 Fertilizer storage 13 Insecticide storage LANDFILL 16 Other (specify below)				
Direction from well?				
FROM 7 TO 4 LITHOLOGIC LOG SILTY GRAYISH BEN CLAY	FROM 4 TO 3 SILTY YEL BEN CLAY W/	FROM 3 TO 2 h.s FRAGS	FROM 2 TO 14' TAN h.s W/ WATER	PLUGGING INTERVALS
8-6				
7 CONTRACTOR'S OR LANDOWNER'S CERTIFICATION: This water well was 1 constructed, 2 reconstructed, or 3 plugged under my jurisdiction and was completed on (mo/day/year) 7-5-95 and this record is true to the best of my knowledge and belief. Kansas Water Well Contractor's License No. 1568 This Water Well Record was completed on (mo/day/yr) 7-5-95 by (signature) David H. Hargan				

INSTRUCTIONS: Use typewriter or ball point pen. PLEASE PRESS FIRMLY and PRINT clearly. Please fill in blanks, underline or circle the correct answers. Send top three copies to Kansas Department of Health and Environment, Bureau of Water, Topeka, Kansas 66620-0001. Telephone: 913-296-5545. Send one to WATER WELL OWNER and retain one for your records.