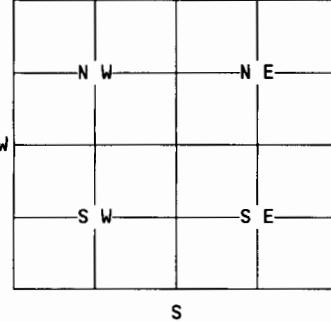


1	LOCATION OF WATER WELL:	Fraction	Section Number	Township Number	Range Number
	County: Butler	SE $\frac{1}{4}$ SE $\frac{1}{4}$ SE $\frac{1}{4}$	15	26 S	5 E
Distance and direction from nearest town or city street address of well if located within city? 1 3/4 mi. S $\frac{1}{4}$ mi. W from 1401 S. Douglas Rd., El Dorado, KS 67042					
2	WATER WELL OWNER: Mr. R. C. Sheffield, Texaco Refining and Marketing Inc. 1401 S. Douglas Rd.	Board of Agriculture, Division of Water Resources Application Number:			
RR#, St. Address, Box #:	P. O. Box 1121				
City, State, ZIP Code :		El Dorado, KS 67042			
3	MARK WELL'S LOCATION WITH AN "X" IN SECTION BOX:  	4	DEPTH OF WELL.....37.....ft.		
			WELL'S STATIC WATER LEVEL...20.....ft.		
			WELL WAS USED AS:		
			<input checked="" type="checkbox"/> Domestic	5 Public Water Supply	9 Dewatering
			<input type="checkbox"/> Irrigation	6 Oil Field Water Supply	10 Monitoring Well
			<input type="checkbox"/> Feedlot	7 Lawn and Garden Only	11 Injection Well
			<input type="checkbox"/> Industrial	8 Air Conditioning	12 Other.....
5	Was a chemical/bacteriological sample submitted to Department? Yes....No.X.. If yes, mo/day/yr sample was submitted.....				
	Water Well Disinfected: Yes..X... No.....				
5	TYPE OF BLANK CASING USED:				
	<input type="checkbox"/> 1 Steel	<input type="checkbox"/> 3 RMP (SR)	<input type="checkbox"/> 5 Wrought	<input type="checkbox"/> 7 Fiberglass	9 Other (specify below)
	<input checked="" type="checkbox"/> 2 PVC	<input type="checkbox"/> 4 ABS	<input type="checkbox"/> 6 Asbestos-Cement	<input type="checkbox"/> 8 Concrete Tile	.....
6	Blank casing diameter....6.....in. Was casing pulled? Yes..... No.X... If yes, how much.....				
	Casing height above or below land surface.....48.....in.				
6	GROUT PLUG MATERIAL: <input checked="" type="checkbox"/> 1 Neat cement    2 Cement grout    3 Bentonite    4 Other.....				
	Grout Plug Intervals: From 20..ft. to 37..ft., From 12..ft. to 20..ft., From 7.5. to 12..ft.				
	What is the nearest source of possible contamination:				
	1 Septic tank	6 Seepage pit	11 Fuel storage	<input checked="" type="checkbox"/> 16 Other (specify below) Constructed Wetland	
	2 Sewer lines	7 Pit privy	12 Fertilizer storage		
	3 Watertight sewer lines	8 Sewage lagoon	13 Insecticide storage		
	4 Lateral lines	9 Feedyard	14 Abandoned water well		
	5 Cess Pool	10 Livestock pens	15 Oil well/Gas well		
	Direction from well? ..Above Well.....			How many feet? .....3.5.....	
FROM	TO	PLUGGING MATERIALS			
20	37	Washed Chlorinated Sand			
12	20	Bentonite			
7.5	12	Neat Cement			
7	CONTRACTOR'S OR LANDOWNER'S CERTIFICATION: This water well was plugged under my jurisdiction and was completed on (mo/day/year).....8/26/95..... and this record is true to the best of my knowledge and belief. Kansas Water Well Contractor's License No. ..N/A..... This Water Well Record was completed on (mo/day/year).....8/29/95..... under the business name of ..Texaco Refining and Marketing Inc.....				
	by (signature) ..R.C. Sheffield, Texaco Refining and Marketing Inc.....				

INSTRUCTIONS: Use typewriter or ball point pen. Please press firmly and print clearly. Please fill in blanks, underline or circle the correct answers. Send top three copies to Kansas Department of Health and Environment, Bureau of Water, Topeka, Kansas 66620-0001. Telephone: 913/296-3565. Send one to Water Well Owner and retain one for your records.