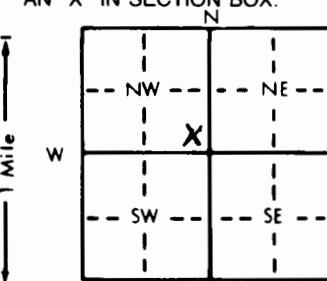


PLUGGED

WATER WELL RECORD Form WWC-5 KSA 82a-1212

Form WWC-5 KSA 82a-1212

W-40

1 LOCATION OF WATER WELL: County: <u>Butler</u>		Fraction <u>SE 1/4 SE 1/4 NW 1/4</u>	Section Number <u>15</u>	Township Number <u>T 26 S</u>	Range Number <u>R 5 EW</u>
Distance and direction from nearest town or city street address of well if located within city?					
2 WATER WELL OWNER: RR#, St. Address, Box # City, State, ZIP Code		<u>Texaco Refining & Marketing Inc Eldorado, KS</u>			
3 LOCATE WELL'S LOCATION WITH AN "X" IN SECTION BOX: 					
4 DEPTH OF COMPLETED WELL <u>17</u> ft. ELEVATION: _____					
Depth(s) Groundwater Encountered 1. ft. 2. ft. 3. ft.					
WELL'S STATIC WATER LEVEL ft. below land surface measured on mo/day/yr					
Pump test data: Well water was ft. after hours pumping gpm					
Est. Yield gpm: Well water was ft. after hours pumping gpm					
Bore Hole Diameter in. to ft. and in. to ft.					
WELL WATER TO BE USED AS: 5 Public water supply 8 Air conditioning 11 Injection well 1 Domestic 3 Feedlot 6 Oil field water supply 9 Dewatering 12 Other (Specify below) 2 Irrigation 4 Industrial 7 Lawn and garden only 10 Monitoring well					
Was a chemical/bacteriological sample submitted to Department? Yes No If yes, mo/day/yr sample was submitted					
Water Well Disinfected? Yes No					
5 TYPE OF BLANK CASING USED: 1 Steel 3 RMP (SR) 5 Wrought iron 8 Concrete tile CASING JOINTS: Glued Clamped 2 PVC 4 ABS 6 Asbestos-Cement 9 Other (specify below) Welded Blank casing diameter <u>4</u> in. to ft., Dia in. to ft., Dia in. to ft. Casing height above land surface <u>2.5</u> ft., weight lbs./ft. Wall thickness or gauge No. <u>sch 40</u>					
6 TYPE OF SCREEN OR PERFORATION MATERIAL: 1 Steel 3 Stainless steel 5 Fiberglass 7 PVC 10 Asbestos-cement 2 Brass 4 Galvanized steel 6 Concrete tile 8 RMP (SR) 11 Other (specify) SCREEN OR PERFORATION OPENINGS ARE: 1 Continuous slot 3 Mill slot 5 Gauzed wrapped 8 Saw cut 11 None (open hole) 2 Louvered shutter 4 Key punched 6 Wire wrapped 9 Drilled holes SCREEN-PERFORATED INTERVALS: From <u>2.5</u> ft. to <u>17</u> ft. From ft. to ft. From ft. to ft. From ft. to ft. GRAVEL PACK INTERVALS: From <u>17</u> ft. to <u>0</u> ft. From ft. to ft. From ft. to ft. From ft. to ft.					
7 GROUT MATERIAL: 1 Neat cement 2 Cement grout 3 Bentonite 4 Other <u>Soil</u> Grout Intervals: From <u>17</u> ft. to <u>-2</u> ft., From ft. to ft., From ft. to ft., From ft. to ft. What is the nearest source of possible contamination: 1 Septic tank 4 Lateral lines 7 Pit privy 10 Livestock pens 14 Abandoned water well 2 Sewer lines 5 Cess pool 8 Sewage lagoon 11 Fuel storage 15 Oil well/Gas well 3 Watertight sewer lines 6 Seepage pit 9 Feedyard 12 Fertilizer storage 16 Other (specify below) Direction from well?					
FROM TO LITHOLOGIC LOG			FROM	TO	PLUGGING INTERVALS
		Plugged 9-17-97	<u>17</u>	<u>-2</u>	<u>2 x bentonite chips</u>
			<u>2</u>	<u>0</u>	<u>Soil</u>

7 CONTRACTOR'S OR LANDOWNER'S CERTIFICATION: This water well was (1) constructed, (2) reconstructed, or (3) plugged under my jurisdiction and was completed on (mo/day/year) 9-14-97 and this record is true to the best of my knowledge and belief. Kansas

Water Well Contractor's License No. 581 This Water Well Record was completed on (mo/day/yr) 10-20-97
under the business name of Laurene Western by (signature) Shane M. Western

INSTRUCTIONS: Use typewriter or ball point pen. PLEASE PRESS FIRMLY and PRINT clearly. Please fill in blanks, underline or circle the correct answers. Send top three copies to Kansas Department of Health and Environment, Bureau of Water, Topeka, Kansas 66620-0001. Telephone: 913-296-5545. Send one to WATER WELL OWNER and retain one for your records.