

PLUGGED

WATER WELL RECORD Form WWC-5 KSA 82a-1212

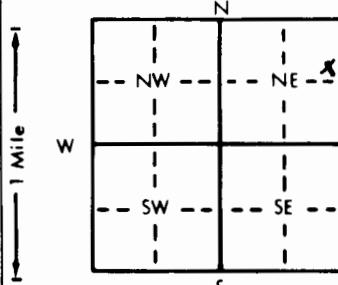
W-11

1 LOCATION OF WATER WELL:	Fraction County: Butler	SE $\frac{1}{4}$ NE $\frac{1}{4}$ NE $\frac{1}{4}$	Section Number 15	Township Number T 26 S	Range Number R 5 EW
---------------------------	----------------------------	--	----------------------	---------------------------	------------------------

Distance and direction from nearest town or city street address of well if located within city?

W-11

2 WATER WELL OWNER: Texaco Refining & Marketing

Board of Agriculture, Division of Water Resources
Application Number:3 LOCATE WELL'S LOCATION WITH
AN "X" IN SECTION BOX:

4 DEPTH OF COMPLETED WELL: 33.6 ft. ELEVATION:

Depth(s) Groundwater Encountered 1. ft. 2. ft. 3. ft.

WELL'S STATIC WATER LEVEL ft. below land surface measured on mo/day/yr

Pump test data: Well water was ft. after hours pumping gpm

Est. Yield gpm: Well water was ft. after hours pumping gpm

Bore Hole Diameter in. to ft., and in. to ft.

WELL WATER TO BE USED AS: 5 Public water supply 8 Air conditioning 11 Injection well

1 Domestic 3 Feedlot 6 Oil field water supply 9 Dewatering 12 Other (Specify below)

2 Irrigation 4 Industrial 7 Lawn and garden only 10 Monitoring well

Was a chemical/bacteriological sample submitted to Department? Yes.....No..... If yes, mo/day/yr sample was submitted

Water Well Disinfected? Yes No

5 TYPE OF BLANK CASING USED:

1 Steel 3 RMP (SR)
2 PVC 4 ABS

5 Wrought iron

8 Concrete tile

CASING JOINTS: Glued Clamped

6 Asbestos-Cement

9 Other (specify below)

Welded

7 Fiberglass

Threaded

Blank casing diameter in. to ft., Dia in. to ft., Dia in. to ft.

Casing height above land surface in., weight lbs./ft. Wall thickness or gauge No.

TYPE OF SCREEN OR PERFORATION MATERIAL:

1 Steel 3 Stainless steel
2 Brass 4 Galvanized steel

5 Fiberglass

7 PVC

10 Asbestos-cement

6 Concrete tile

8 RMP (SR)

11 Other (specify)

5 Gauzed wrapped

9 ABS

12 None used (open hole)

11 None (open hole)

SCREEN OR PERFORATION OPENINGS ARE:

1 Continuous slot 3 Mill slot
2 Louvered shutter 4 Key punched

6 Wire wrapped

7

8 Saw cut

9 Drilled holes

7 Torch cut

10 Other (specify)

SCREEN-PERFORATED INTERVALS: From ft. to ft., From ft. to ft.

From ft. to ft., From ft. to ft.

GRAVEL PACK INTERVALS: From ft. to ft., From ft. to ft.

From ft. to ft., From ft. to ft.

6 GROUT MATERIAL: 1 Neat cement 2 Cement grout 3 Bentonite 4 Other

Grout Intervals: From 33.6 ft. to 0 ft., From ft. to ft., From ft. to ft.

What is the nearest source of possible contamination:

1 Septic tank 4 Lateral lines
2 Sewer lines 5 Cess pool
3 Watertight sewer lines 6 Seepage pit

7 Pit privy

8 Sewage lagoon

9 Feedyard

10 Livestock pens

11 Fuel storage

12 Fertilizer storage

13 Insecticide storage

14 Abandoned water well

15 Oil well/Gas well

16 Other (specify below)

Direction from well?

How many feet?

FROM TO LITHOLOGIC LOG FROM TO PLUGGING INTERVALS

Plugged 9-18-97

33.6

0

5.5 sx hole plug

7 CONTRACTOR'S OR LANDOWNER'S CERTIFICATION: This water well was (1) constructed, (2) reconstructed, or (3) plugged under my jurisdiction and was completed on (mo/day/year) 9-18-97 and this record is true to the best of my knowledge and belief, Kansas

Water Well Contractor's License No. 581 This Water Well Record was completed on (mo/day/year) 10-19-97 by (signature) Steve Mitchell

Layne Weston

by (signature)