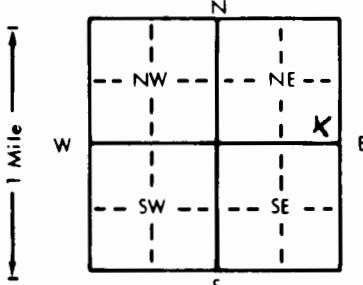


Plugged

## WATER WELL RECORD Form WWC-5 KSA 82a-1212

W-9

1 LOCATION OF WATER WELL: County: Butler		Fraction SE $\frac{1}{4}$ SE $\frac{1}{4}$ NE $\frac{1}{4}$	Section Number 15	Township Number T 26 S	Range Number R 5 E
Distance and direction from nearest town or city street address of well if located within city?					
2 WATER WELL OWNER: RR#, St. Address, Box # City, State, ZIP Code		Texaco Refining & Marketing Eldorado, KS			
3 LOCATE WELL'S LOCATION WITH AN "X" IN SECTION BOX: N 					
4 DEPTH OF COMPLETED WELL: 23.7 ft.		ELEVATION: _____			
Depth(s) Groundwater Encountered 1. ft. 2. ft. 3. ft.					
WELL'S STATIC WATER LEVEL ft. below land surface measured on mo/day/yr					
Pump test data: Well water was ft. after hours pumping gpm					
Est. Yield gpm: Well water was ft. after hours pumping gpm					
Bore Hole Diameter in. to ft. and in. to ft.					
WELL WATER TO BE USED AS: 5 Public water supply 8 Air conditioning 11 Injection well 1 Domestic 3 Feedlot 6 Oil field water supply 9 Dewatering 12 Other (Specify below) 2 Irrigation 4 Industrial 7 Lawn and garden only 10 Monitoring well					
Was a chemical/bacteriological sample submitted to Department? Yes. No. If yes, mo/day/yr sample was submitted					
Water Well Disinfected? Yes No					
5 TYPE OF BLANK CASING USED: 5 Wrought iron 8 Concrete tile Casing joints: Glued Clamped 1 Steel 3 RMP (SR) 6 Asbestos-Cement 9 Other (specify below) Welded 2 PVC 4 ABS 7 Fiberglass Threaded					
Blank casing diameter in. to ft., Dia. in. to ft., Dia. in. to ft.					
Casing height above land surface in., weight lbs./ft. Wall thickness or gauge No.					
TYPE OF SCREEN OR PERFORATION MATERIAL: 7 PVC 10 Asbestos-cement 1 Steel 3 Stainless steel 5 Fiberglass 8 RMP (SR) 2 Brass 4 Galvanized steel 6 Concrete tile 9 ABS 11 Other (specify) 12 None used (open hole) 13 None (open hole)					
SCREEN OR PERFORATION OPENINGS ARE: 5 Gauzed wrapped 8 Saw cut 11 None (open hole) 1 Continuous slot 3 Mill slot 6 Wire wrapped 9 Drilled holes 2 Louvered shutter 4 Key punched 7 Torch cut 10 Other (specify)					
SCREEN-PERFORATED INTERVALS: From. ft. to ft., From. ft. to ft.					
GRAVEL PACK INTERVALS: From. ft. to ft., From. ft. to ft.					
6 GROUT MATERIAL: 1 Neat cement 2 Cement grout 3 Bentonite 4 Other Soil Grout Intervals: From. 23.7 ft. to 3 ft., From. 0 ft. to 3 ft., From. 3 ft. to ft., From. ft. to ft.					
What is the nearest source of possible contamination: 10 Livestock pens 14 Abandoned water well 1 Septic tank 4 Lateral lines 7 Pit privy 11 Fuel storage 15 Oil well/Gas well 2 Sewer lines 5 Cess pool 8 Sewage lagoon 12 Fertilizer storage 16 Other (specify below) 3 Watertight sewer lines 6 Seepage pit 9 Feedyard 13 Insecticide storage					
Direction from well? How many feet?					
FROM	TO	LITHOLOGIC LOG		FROM	TO
Plugged 9-19-97		23.7	3	3 sx chips bentonite	
		0	3	Unable to pull casing. Cut casing 3' bgs	
				Clay / soil	
7 CONTRACTOR'S OR LANDOWNER'S CERTIFICATION: This water well was (1) constructed, (2) reconstructed, or (3) plugged under my jurisdiction and was completed on (mo/day/year) 9-19-97 and this record is true to the best of my knowledge and belief, Kansas					
Water Well Contractor's License No. 581 This Water Well Record was completed on (mo/day/year) 10-19-97 under the business name of Layne Weston by (signature) Steve Mitchell					