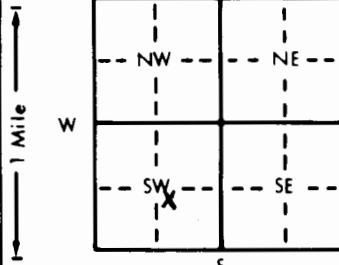


WATER WELL RECORD Form WWC-5 KSA 82a-1212

1 LOCATION OF WATER WELL:	Fraction County: <i>Butler</i>	Section Number 10	Township Number T 26 S	Range Number R 5 EW	
Distance and direction from nearest town or city street address of well if located within city?					
2 WATER WELL OWNER:	<i>Texaco Marketing & Refining</i>				
RR#, St. Address, Box #	Board of Agriculture, Division of Water Resources				
City, State, ZIP Code	Application Number:				
3 LOCATE WELL'S LOCATION WITH AN "X" IN SECTION BOX:					
4 DEPTH OF COMPLETED WELL	30 ft. ELEVATION:				
Depth(s) Groundwater Encountered	1	ft. 2	ft. 3	ft.	
WELL'S STATIC WATER LEVEL	15	ft. below land surface measured on mo/day/yr			
Pump test data: Well water was		ft. after	hours pumping	gpm	
Est. Yield	gpm:	Well water was	ft. after	hours pumping	
Bore Hole Diameter	48	in. to	30	ft. and in. to ft.	
WELL WATER TO BE USED AS:	5 Public water supply	8 Air conditioning	11 Injection well		
1 Domestic	3 Feedlot	6 Oil field water supply	9 Dewatering	12 Other (Specify below)	
2 Irrigation	4 Industrial	7 Lawn and garden only	10 Monitoring well	<i>Sump</i>	
Was a chemical/bacteriological sample submitted to Department? Yes	No	Water Well Disinfected? Yes	No		
5 TYPE OF BLANK CASING USED:	5 Wrought iron	8 Concrete tile	CASING JOINTS: Glued Clamped		
1 Steel	3 RMP (SR)	6 Asbestos-Cement	9 Other (specify below)	Welded X	
2 PVC	4 ABS	7 Fiberglass	<i>Culvert</i>		
Blank casing diameter	36 in. to 10	ft., Dia	in. to	ft., Dia in. to ft.	
Casing height above land surface	12 in.	weight	lbs./ft. Wall thickness or gauge No.		
TYPE OF SCREEN OR PERFORATION MATERIAL:	7 PVC	10 Asbestos-cement			
1 Steel	3 Stainless steel	8 RMP (SR)			
2 Brass	4 Galvanized steel	6 Concrete tile	9 ABS	11 Other (specify) <i>galv. culvert</i>	
SCREEN OR PERFORATION OPENINGS ARE:	5 Gauzed wrapped	12 Torch cut	10 None (open hole)		
1 Continuous slot	3 Mill slot	6 Wire wrapped	8 Saw cut	11 None (open hole)	
2 Louvered shutter	4 Key punched	7	9 Drilled holes		
SCREEN-PERFORATED INTERVALS:	From 10 ft. to 30 ft.	ft., From	ft. to ft., From	ft. to ft.	
GRAVEL PACK INTERVALS:	From 8 ft. to 30 ft.	ft., From	ft. to ft., From	ft. to ft.	
6 GROUT MATERIAL:	1 Neat cement	2 Cement grout	3 Bentonite	4 Other	
Grout Intervals:	From 4 ft. to 8 ft.	ft., From	ft. to ft., From	ft. to ft.	
What is the nearest source of possible contamination:	10 Livestock pens	14 Abandoned water well			
1 Septic tank	7 Pit privy	11 Fuel storage			
2 Sewer lines	8 Sewage lagoon	12 Fertilizer storage			
3 Watertight sewer lines	9 Feedyard	13 Insecticide storage			
6 Seepage pit	How many feet?				
Direction from well?	<i>Within refinery</i>				
FROM	TO	LITHOLOGIC LOG	FROM	TO	PLUGGING INTERVALS
0	6	<i>Brown/Bk Clay & fill material</i>			
6	8	<i>Gray/gun shale</i>			
8	30	<i>Lt. tan ls & sh stringers</i>			
7 CONTRACTOR'S OR LANDOWNER'S CERTIFICATION:	This water well was (1) constructed, (2) reconstructed, or (3) plugged under my jurisdiction and was completed on (mo/day/year) <i>9-28-97</i> and this record is true to the best of my knowledge and belief, Kansas				
Water Well Contractor's License No.	58	This Water Well Record was completed on (mo/day) <i>10-28-97</i> by (signature) <i>Steve Nutch</i>			
under the business name of	<i>Layne Weston</i>				