

WATER WELL RECORD

Form WWC-5

KSA 82a-1212

1 LOCATION OF WATER WELL:

Fraction

NW $\frac{1}{4}$ NW $\frac{1}{4}$ SE $\frac{1}{4}$

Section Number

3

Township Number

T

26

S

Range Number

R

5

NW

County: BUTLER

Distance and direction from nearest town or city street address of well if located within city?

1631 W CENTRAL, EL DORADO

2 WATER WELL OWNER:

CONOCO


RR#, St. Address, Box #: 600 N. DAILEY Ashford

City, State, ZIP Code: HOUSTON, TX 77075-6651

Board of Agriculture, Division of Water Resources

Application Number:

3 LOCATE WELL'S LOCATION WITH AN "X" IN SECTION BOX:

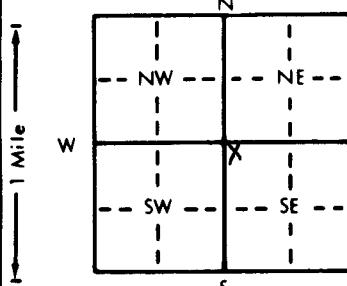

4 DEPTH OF COMPLETED WELL: 12 ft. ELEVATION: 1321.49

Depth(s) Groundwater Encountered 1 ft. 2 ft. 3 ft. ft.

WELL'S STATIC WATER LEVEL: 12 ft. below land surface measured on mo/day/yr 10/21/58

Pump test data: Well water was ft. after hours pumping gpm

Est. Yield gpm: Well water was ft. after hours pumping gpm

Bore Hole Diameter: 8.25 in. to 12 ft. and in. to ft.

WELL WATER TO BE USED AS: 5 Public water supply 8 Air conditioning 11 Injection well

1 Domestic 3 Feedlot 6 Oil field water supply 9 Dewatering 12 Other (Specify below)

2 Irrigation 4 Industrial 7 Lawn and garden only 10 Monitoring well MW-1

Was a chemical/bacteriological sample submitted to Department? Yes X No If yes, mo/day/yr sample was submitted 10/24/58 Water Well Disinfected? Yes No

5 TYPE OF BLANK CASING USED:

1 Steel 3 RMP (SR)

5 Wrought iron 8 Concrete tile Casing Joints: Glued Clamped

2 PVC 4 ABS

6 Asbestos-Cement 9 Other (specify below)

Welded

Threaded

Blank casing diameter: 2 in. to 4.5 ft. Dia. in. to ft. Dia. in. to ft.

Casing height above land surface: 0 in. weight lbs./ft. Wall thickness or gauge No. 80

TYPE OF SCREEN OR PERFORATION MATERIAL:

1 Steel 3 Stainless steel

7 PVC 10 Asbestos-cement

2 Brass 4 Galvanized steel

8 RMP (SR)

11 Other (specify)

6 Concrete tile 9 ABS

12 None used (open hole)

SCREEN OR PERFORATION OPENINGS ARE:

1 Continuous slot 3 Mill slot

5 Gauzed wrapped

8 Saw cut

11 None (open hole)

2 Louvered shutter 4 Key punched

6 Wire wrapped

9 Drilled holes

10 Other (specify)

SCREEN-PERFORATED INTERVALS: From: 4.5 ft. to 11 ft. From: ft. to ft.

7 Torch cut

ft. to ft.

From: 4.5 ft. to 11 ft. From: ft. to ft.

GRAVEL PACK INTERVALS: From: 3.5 ft. to 12 ft. From: ft. to ft.

From: ft. to ft. From: ft. to ft.

6 GROUT MATERIAL: 1 Neat cement 2 Cement grout 3 Bentonite 4 Other CONCRETE

Grout Intervals: From: 0 ft. to 0.15 ft. From: 0.15 ft. to 3.5 ft. From: ft. to ft.

What is the nearest source of possible contamination:

1 Septic tank 4 Lateral lines

10 Livestock pens

14 Abandoned water well

2 Sewer lines 5 Cess pool

11 Fuel storage

15 Oil well/Gas well

3 Watertight sewer lines 6 Seepage pit

12 Fertilizer storage

16 Other (specify below)

7 Pit privy

13 Insecticide storage

8 Sewage lagoon

How many feet?

9 Feedyard

Direction from well?

FROM TO LITHOLOGIC LOG FROM TO PLUGGING INTERVALS

0 2 Fill

2 10 Clay - LEAN TO FAT TO SILTY BROWN

10 12 LIMESTONE - WEATHERED

7 CONTRACTOR'S OR LANDOWNER'S CERTIFICATION: This water well was 1 constructed, 2 reconstructed, or 3 plugged under my jurisdiction and was completed on (mo/day/year) 10-21-58 and this record is true to the best of my knowledge and belief. Kansas

Water Well Contractor's License No. 614 This Water Well Record was completed on (mo/day/yr) 11-24-58

under the business name of MAXIM TECH by (signature) William Stofford