

WATER WELL RECORD

Form WWC-5

KSA 82a-1212

1 LOCATION OF WATER WELL:

County: BUTLER

Fraction

NW $\frac{1}{4}$ NW $\frac{1}{4}$ SE $\frac{1}{4}$

Section Number

3

Township Number

T 26 S

Range Number

R 5 E

Distance and direction from nearest town or city street address of well if located within city?

1631 W. CENTPAC, EC DORADO KS

2 WATER WELL OWNER:

CONOCO FNC.


RR#, St. Address, Box # : 600 N. DAILEY Ashford

City, State, ZIP Code : HOUSTON TX, 77079-6651

Board of Agriculture, Division of Water Resources

Application Number:

3 LOCATE WELL'S LOCATION WITH AN "X" IN SECTION BOX:

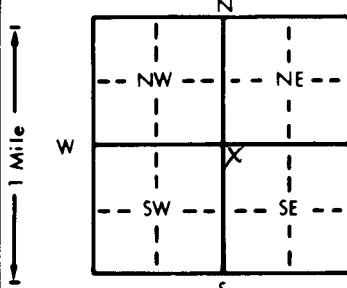

4 DEPTH OF COMPLETED WELL: 11.7 ft. ELEVATION: 1321.74

Depth(s) Groundwater Encountered 1 ft. 2 ft. 3 ft. ft.

WELL'S STATIC WATER LEVEL: 9.3 ft. below land surface measured on mo/day/yr 10-21-98

Pump test data: Well water was ft. after hours pumping gpm

Est. Yield gpm: Well water was ft. after hours pumping gpm

Bore Hole Diameter: 8.25 in. to 11.7 ft. and in. to ft.

WELL WATER TO BE USED AS: 5 Public water supply 8 Air conditioning 11 Injection well

1 Domestic 3 Feedlot 6 Oil field water supply 9 Dewatering 12 Other (Specify below)

2 Irrigation 4 Industrial 7 Lawn and garden only 10 Monitoring well MW-0

Was a chemical/bacteriological sample submitted to Department? Yes No. If yes, mo/day/yr sample was submitted 10-24-98

Water Well Disinfected? Yes No

5 TYPE OF BLANK CASING USED:

1 Steel 3 RMP (SR)

5 Wrought iron 8 Concrete tile Casing Joints: Glued Clamped

2 PVC 4 ABS

6 Asbestos-Cement 9 Other (specify below)

Welded Threaded

Blank casing diameter: 7 in. to 7 ft., Dia. in. to ft., Dia. in. to ft.

Casing height above land surface: 0 in., weight lbs./ft. Wall thickness or gauge No. 80

TYPE OF SCREEN OR PERFORATION MATERIAL:

1 Steel 3 Stainless steel

① PVC 10 Asbestos-cement

2 Brass 4 Galvanized steel

5 Fiberglass 8 RMP (SR)

11 Other (specify)

6 Concrete tile 9 ABS 12 None used (open hole)

SCREEN OR PERFORATION OPENINGS ARE:

1 Continuous slot 3 Mill slot

5 Gauzed wrapped 8 Saw cut 11 None (open hole)

2 Louvered shutter 4 Key punched

6 Wire wrapped 9 Drilled holes

7 Torch cut 10 Other (specify)

SCREEN-PERFORATED INTERVALS: From: 7 ft. to 12 ft., From: ft. to ft.

From: ft. to ft., From: ft. to ft.

GRAVEL PACK INTERVALS: From: 6 ft. to 12 ft., From: ft. to ft.

From: ft. to ft., From: ft. to ft.

6 GROUT MATERIAL: 1 Neat cement 2 Cement grout ③ Bentonite ④ Other CONCRETE

Grout Intervals: From: 0 ft. to 3 ft., From: 3 ft. to 6 ft., From: ft. to ft.

What is the nearest source of possible contamination:

1 Septic tank 4 Lateral lines

10 Livestock pens

14 Abandoned water well

2 Sewer lines 5 Cess pool

⑪ Fuel storage

15 Oil well/Gas well

3 Watertight sewer lines 6 Seepage pit

12 Fertilizer storage

16 Other (specify below)

7 Pit privy

13 Insecticide storage

8 Sewage lagoon

How many feet?

9 Feedyard

Direction from well?

FROM TO LITHOLOGIC LOG FROM TO PLUGGING INTERVALS

0 1 F11

1 4 CLAY - DK BROWN - MOTTLED

4 6 WEATHERIZED LIMESTONE

with SAND & CLAY - T11

6 8.5 CLAY with BANDED LIMESTONE

8.5 11.7 CLAY - grey to BROWN

11.7 LIMESTONE

7 CONTRACTOR'S OR LANDOWNER'S CERTIFICATION: This water well was ① constructed, ② reconstructed, or ③ plugged under my jurisdiction and was completed on (mo/day/year) 10-21-98 and this record is true to the best of my knowledge and belief. Kansas

Water Well Contractor's License No. 614 This Water Well Record was completed on (mo/day/yr) 11-27-98

under the business name of MAXIM TECH by (signature) William Stefford