

WATER WELL RECORD

Form WWC-5

KSA 82a-1212

1 LOCATION OF WATER WELL:

Fraction

NW $\frac{1}{4}$ NW $\frac{1}{4}$ SE $\frac{1}{4}$ SE $\frac{1}{4}$

Section Number

3

Township Number

T

26

S

Range Number

R 5

NW

County: BUTLER
Distance and direction from nearest town or city street address of well if located within city?

1631 W. CENTRAL, EL DORADO

2 WATER WELL OWNER: CONOCO INC.


RR#, St. Address, Box # : 600 N. Dailey Ashford

Board of Agriculture, Division of Water Resources

City, State, ZIP Code : HOUSTON, TX 77079-6651

Application Number:

3 LOCATE WELL'S LOCATION WITH AN "X" IN SECTION BOX:

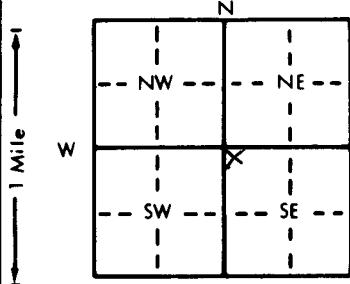

4 DEPTH OF COMPLETED WELL 18 ft. ELEVATION: 1322.16

Depth(s) Groundwater Encountered 1 ft. 2 ft. 3 ft. ft.

WELL'S STATIC WATER LEVEL 11.9 ft. below land surface measured on mo/day/yr 10-22-98

Pump test data: Well water was ft. after hours pumping gpm

Est. Yield gpm: Well water was ft. after hours pumping gpm

Bore Hole Diameter 8.25 in. to 23 ft. and in. to ft.

WELL WATER TO BE USED AS: 5 Public water supply 8 Air conditioning 11 Injection well

1 Domestic 3 Feedlot 6 Oil field water supply 9 Dewatering 12 Other (Specify below)

2 Irrigation 4 Industrial 7 Lawn and garden only 10 Monitoring well MW-7

Was a chemical/bacteriological sample submitted to Department? Yes No; If yes, mo/day/yr sample was submitted 10-24-98

Water Well Disinfected? Yes (No)

5 TYPE OF BLANK CASING USED:

1 Steel 3 RMP (SR)

5 Wrought iron 8 Concrete tile Casing Joints: Glued Clamped

② PVC 4 ABS

6 Asbestos-Cement 9 Other (specify below)

Blank casing diameter 2 in. to 7 ft., Dia. in. to ft., Dia. in. to ft.

Welded

Threaded

Casing height above land surface 0 in., weight lbs./ft. Wall thickness or gauge No. 80

TYPE OF SCREEN OR PERFORATION MATERIAL:

1 Steel 3 Stainless steel

④ PVC 10 Asbestos-cement

2 Brass 4 Galvanized steel

5 Fiberglass 8 RMP (SR) 11 Other (specify)

6 Concrete tile 9 ABS 12 None used (open hole)

SCREEN OR PERFORATION OPENINGS ARE:

1 Continuous slot ③ Mill slot

5 Gauzed wrapped 8 Saw cut 11 None (open hole)

2 Louvered shutter 4 Key punched

6 Wire wrapped 9 Drilled holes

7 Torch cut 10 Other (specify)

SCREEN-PERFORATED INTERVALS: From 7 ft. to 17 ft., From ft. to ft.

From ft. to ft., From ft. to ft.

GRAVEL PACK INTERVALS: From 10 ft. to 18 ft., From ft. to ft.

From ft. to ft., From ft. to ft.

6 GROUT MATERIAL: 1 Neat cement 2 Cement grout ③ Bentonite ④ Other CONCRETE

Grout Intervals: From 0 ft. to 25 ft., From 25 ft. to 6 ft., From 18 ft. to 23 ft.

What is the nearest source of possible contamination:

1 Septic tank 4 Lateral lines

10 Livestock pens 14 Abandoned water well

2 Sewer lines 5 Cess pool

⑪ Fuel storage 15 Oil well/Gas well

3 Watertight sewer lines 6 Seepage pit

12 Fertilizer storage 16 Other (specify below)

13 Insecticide storage

Direction from well?

How many feet?

FROM TO LITHOLOGIC LOG FROM TO PLUGGING INTERVALS

0 13.5 CLAY - RED TO BROWN

13.5 14 LIMESTONE

14 14.5 CLAY - BROWN

14.5 23 WEATHERED SHALE - grey

7 CONTRACTOR'S OR LANDOWNER'S CERTIFICATION: This water well was ① constructed, ② reconstructed, or ③ plugged under my jurisdiction and was

completed on (mo/day/year) 10-22-98 and this record is true to the best of my knowledge and belief. Kansas

Water Well Contractor's License No. 614 This Water Well Record was completed on (mo/day/yr) 11-24-98

under the business name of MAXIM TECH by (signature) William Clifford