

WATER WELL RECORD

Form WWC-5

KSA 82a-1212

1 LOCATION OF WATER WELL:

County: BUTLER

Fraction

NW 1/4 NW 1/4 SE 1/4

Section Number

3

Township Number

T 26 S

Range Number

R 5 EW

Distance and direction from nearest town or city street address of well if located within city?

1631 W. CENTRAL, EL DORADO

2 WATER WELL OWNER:

CONOCO INC.


RR#, St. Address, Box #: 600 N DAIRY Ashford

Board of Agriculture, Division of Water Resources

City, State, ZIP Code: HOUSTON TX 77079-6651

Application Number:

3 LOCATE WELL'S LOCATION WITH AN "X" IN SECTION BOX:

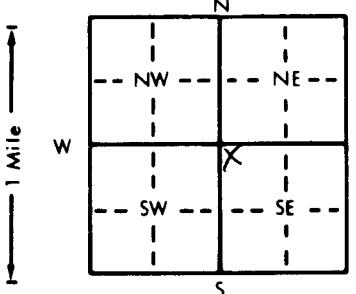

4 DEPTH OF COMPLETED WELL: 16.5 ft. ELEVATION: 1321.80

Depth(s) Groundwater Encountered 1 ft. 2 ft. 3 ft.

WELL'S STATIC WATER LEVEL: 11.4 ft. below land surface measured on mo/day/yr 10-22-98

Pump test data: Well water was ft. after hours pumping gpm

Est. Yield gpm: Well water was ft. after hours pumping gpm

Bore Hole Diameter: 6.25 in. to 30 ft. and in. to ft.

WELL WATER TO BE USED AS: 5 Public water supply 8 Air conditioning 11 Injection well

1 Domestic 3 Feedlot 6 Oil field water supply 9 Dewatering 12 Other (Specify below)

2 Irrigation 4 Industrial 7 Lawn and garden only 10 Monitoring well MW-8

Was a chemical/bacteriological sample submitted to Department? Yes No If yes, mo/day/yr sample was submittedWater Well Disinfected? Yes No

5 TYPE OF BLANK CASING USED:

5 Wrought iron 8 Concrete tile CASING JOINTS: Glued Clamped

1 Steel 3 RMP (SR)

6 Asbestos-Cement 9 Other (specify below)

2 PVC 4 ABS

7 Fiberglass

Welded

Threaded

Blank casing diameter 2 in. to 6.5 ft. Dia in. to ft. Dia in. to ft.

Casing height above land surface 0 in. weight lbs./ft. Wall thickness or gauge No. 80

TYPE OF SCREEN OR PERFORATION MATERIAL:

7 PVC 10 Asbestos-cement

1 Steel 3 Stainless steel

5 Fiberglass 8 RMP (SR)

2 Brass 4 Galvanized steel

6 Concrete tile 9 ABS

11 Other (specify)

12 None used (open hole)

SCREEN OR PERFORATION OPENINGS ARE:

5 Gauzed wrapped 8 Saw cut 11 None (open hole)

1 Continuous slot 3 Mill slot

6 Wire wrapped

9 Drilled holes

2 Louvered shutter 4 Key punched

7 Torch cut

10 Other (specify)

SCREEN-PERFORATED INTERVALS: From 6.5 ft. to 15.5 ft. From ft. to ft. From ft. to ft.

From ft. to ft. From ft. to ft. From ft. to ft.

GRAVEL PACK INTERVALS: From 5.5 ft. to 17.5 ft. From ft. to ft. From ft. to ft.

From ft. to ft. From ft. to ft. From ft. to ft.

6 GROUT MATERIAL: 1 Neat cement 2 Cement grout 3 Bentonite 4 Other CONCRETE

Grout Intervals: From 0 ft. to 2.5 ft. From 2.5 ft. to 5.5 ft. From 5.5 ft. to 17.5 ft. to 30 ft.

What is the nearest source of possible contamination:

10 Livestock pens

14 Abandoned water well

1 Septic tank 4 Lateral lines

11 Fuel storage

15 Oil well/Gas well

2 Sewer lines 5 Cess pool

12 Fertilizer storage

16 Other (specify below)

3 Watertight sewer lines 6 Seepage pit

13 Insecticide storage

Direction from well?

How many feet?

FROM TO LITHOLOGIC LOG FROM TO PLUGGING INTERVALS

FROM	TO	LITHOLOGIC LOG	FROM	TO	PLUGGING INTERVALS
0	6	CLAY - BROWN - MOTTLED			
6	10	WEATHERED LIMESTONE - CLAY LAYERS			
10	12	CLAY			
12	15	LIMESTONE			
15	30	WEATHERED SHALE - grey			
		LIMESTONE STRINGERS 30'			

7 CONTRACTOR'S OR LANDOWNER'S CERTIFICATION: This water well was constructed, reconstructed, or plugged under my jurisdiction and was completed on (mo/day/year) 10-22-98 and this record is true to the best of my knowledge and belief. KansasWater Well Contractor's License No. 614 This Water Well Record was completed on (mo/day/yr) 11-24-98 by (signature) *William Stoff*

under the business name of

MAXIM TECH

INSTRUCTIONS: Use typewriter or ball point pen. PLEASE PRESS FIRMLY and PRINT clearly. Please fill in blanks, underline or circle the correct answers. Send top three copies to Kansas Department of Health and Environment, Bureau of Water, Topeka, Kansas 66620-0001. Telephone: 913-296-5545. Send one to WATER WELL OWNER and retain one for your records.