

## WATER WELL RECORD

Form WWC-5

KSA 82a-1212

## 1 LOCATION OF WATER WELL:

Fraction

NW  $\frac{1}{4}$ NW  $\frac{1}{4}$ SE  $\frac{1}{4}$ 

Section Number

3

Township Number

T 26 S

Range Number

R 5 EW

County: BUTLER

Distance and direction from nearest town or city street address of well if located within city?

1631 W CENTRAL, EL DORADO

## 2 WATER WELL OWNER: CONOCO INC.


RR#, St. Address, Box #: 600 N DAIRY Ashford

Board of Agriculture, Division of Water Resources

City, State, ZIP Code: HOUSTON, TX 77079-6651

Application Number:

## 3 LOCATE WELL'S LOCATION WITH AN "X" IN SECTION BOX:

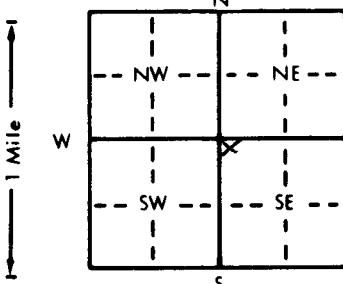

4 DEPTH OF COMPLETED WELL ..... 19 ft. ELEVATION: 1317.64

Depth(s) Groundwater Encountered 1 ft. 2 ft. 3 ft. ft.

WELL'S STATIC WATER LEVEL 14.1 ft. below land surface measured on mo/day/yr 10-22-98

Pump test data: Well water was ..... ft. after ..... hours pumping ..... gpm

Est. Yield ..... gpm: Well water was ..... ft. after ..... hours pumping ..... gpm

Bore Hole Diameter 6.25 in. to 27.5 ft. and ..... in. to ..... ft.

WELL WATER TO BE USED AS: 5 Public water supply 8 Air conditioning 11 Injection well

1 Domestic 3 Feedlot 6 Oil field water supply 9 Dewatering 12 Other (Specify below)

2 Irrigation 4 Industrial 7 Lawn and garden only 10 Monitoring well MW-9

Was a chemical/bacteriological sample submitted to Department? Yes ..... No ..... If yes, mo/day/yr sample was submitted 10-24-98

Water Well Disinfected? Yes No

## 5 TYPE OF BLANK CASING USED:

1 Steel 3 RMP (SR)  
② PVC 4 ABS

5 Wrought iron 8 Concrete tile CASING JOINTS: Glued ..... Clamped .....

6 Asbestos-Cement 9 Other (specify below) Welded .....

Threaded .....

Blank casing diameter ..... 2 in. to ..... 8 ft., Dia ..... in. to ..... ft., Dia ..... in. to ..... ft.

Casing height above land surface ..... 0 in. weight ..... lbs./ft. Wall thickness or gauge No. 80

## TYPE OF SCREEN OR PERFORATION MATERIAL:

1 Steel 3 Stainless steel  
2 Brass 4 Galvanized steel

① PVC 10 Asbestos-cement

5 Fiberglass 8 RMP (SR) 11 Other (specify) .....

6 Concrete tile 9 ABS 12 None used (open hole) .....

## SCREEN OR PERFORATION OPENINGS ARE:

1 Continuous slot ④ Mill slot  
2 Louvered shutter 4 Key punched

5 Gauzed wrapped 8 Saw cut 11 None (open hole)

6 Wire wrapped 9 Drilled holes 10 Other (specify) .....

SCREEN-PERFORATED INTERVALS: From ..... 8 ft. to ..... 15 ft. From ..... ft. to ..... ft.

From ..... ft. to ..... ft. From ..... ft. to ..... ft.

GRAVEL PACK INTERVALS: From ..... 7 ft. to ..... 20 ft. From ..... ft. to ..... ft.

From ..... ft. to ..... ft. From ..... ft. to ..... ft.

## 6 GROUT MATERIAL: 1 Neat cement 2 Cement grout ③ Bentonite ④ Other CONCRETE

Grout Intervals: From ..... 0 ft. to ..... 2.5 ft., From ..... 2.5 ft. to ..... 7 ft., From ..... 7 ft. to ..... 20 ft. to ..... 27.5 ft.

What is the nearest source of possible contamination:

1 Septic tank 4 Lateral lines 7 Pit privy  
2 Sewer lines 5 Cess pool 8 Sewage lagoon  
3 Watertight sewer lines 6 Seepage pit 9 Feedyard

10 Livestock pens 14 Abandoned water well

⑪ Fuel storage 15 Oil well/Gas well  
12 Fertilizer storage 16 Other (specify below)

13 Insecticide storage .....

How many feet?

Direction from well?

FROM	TO	LITHOLOGIC LOG	FROM	TO	PLUGGING INTERVALS
0	5.5	CLAY - RED TO BLACK			
3.5	5.5	WEATHERED LIMESTONE			
5.5	7.8	CLAY - BROWN WITH SAND			
7.8	10	LIMESTONE - WEATHERED			
10	13.8	CLAY - BROWN			
13.8	27.5	WEATHERED SHALE - GREY			

7 CONTRACTOR'S OR LANDOWNER'S CERTIFICATION: This water well was ① constructed, (2) reconstructed, or (3) plugged under my jurisdiction and was completed on (mo/day/year) 10-22-98 and this record is true to the best of my knowledge and belief. Kansas

Water Well Contractor's License No. 614 This Water Well Record was completed on (mo/day/yr) 11-24-98  
under the business name of MAXIM TECH by (signature)