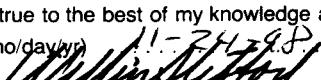


1 LOCATION OF WATER WELL:	Fraction	NW $\frac{1}{4}$ NW $\frac{1}{4}$ SE $\frac{1}{4}$	Section Number	T 26 S	Range Number R 5 EW
County: BUTLER	Distance and direction from nearest town or city street address of well if located within city?				
1631 W. CENTRAL, EL DORADO					
2 WATER WELL OWNER: CONOCO INC.	Board of Agriculture, Division of Water Resources				
RR#, St. Address, Box # : 600 W. DAIRY ASHFOOD	Application Number:				
City, State, ZIP Code : HOUSTON TX 77079-6651					
3 LOCATE WELL'S LOCATION WITH AN "X" IN SECTION BOX:	4 DEPTH OF COMPLETED WELL 17 ft. ELEVATION: 1321.47 Depth(s) Groundwater Encountered 1 ft. 2 ft. 3 ft. WELL'S STATIC WATER LEVEL 11.6 ft. below land surface measured on mo/day/yr 10-23-98 Pump test data: Well water was ft. after hours pumping gpm Est. Yield gpm: Well water was ft. after hours pumping gpm Bore Hole Diameter 6.25 in. to 20 ft., and in. to ft. WELL WATER TO BE USED AS: 5 Public water supply 8 Air conditioning 11 Injection well 1 Domestic 3 Feedlot 6 Oil field water supply 9 Dewatering 12 Other (Specify below) 2 Irrigation 4 Industrial 7 Lawn and garden only 10 Monitoring well MW-10 Was a chemical/bacteriological sample submitted to Department? Yes No If yes, mo/day/yr sample was submitted 10-24-98 Water Well Disinfected? Yes <input checked="" type="checkbox"/> NO				
5 TYPE OF BLANK CASING USED:	5 Wrought iron 8 Concrete tile CASING JOINTS: Glued Clamped 1 Steel 3 RMP (SR) 6 Asbestos-Cement 9 Other (specify below) Welded 2 PVC 4 ABS 7 Fiberglass Threaded Blank casing diameter 2 in. to 17 ft., Dia in. to ft., Dia in. to ft. Casing height above land surface 0 in., weight lbs./ft. Wall thickness or gauge No. 80				
TYPE OF SCREEN OR PERFORATION MATERIAL:	1 PVC 10 Asbestos-cement 2 Brass 3 Stainless steel 5 Fiberglass 8 RMP (SR) 11 Other (specify) 4 Galvanized steel 6 Concrete tile 9 ABS 12 None used (open hole)				
SCREEN OR PERFORATION OPENINGS ARE:	1 Continuous slot 5 Gauzed wrapped 8 Saw cut 11 None (open hole) 2 Louvered shutter 6 Wire wrapped 9 Drilled holes 3 Key punched 7 Torch cut 10 Other (specify) 4 Mill slot				
SCREEN-PERFORATED INTERVALS:	From 7 ft. to 16 ft., From ft. to ft. From ft. to ft., From ft. to ft.				
GRAVEL PACK INTERVALS:	From 6 ft. to 17 ft., From ft. to ft. From ft. to ft., From ft. to ft.				
6 GROUT MATERIAL:	1 Neat cement 2 Cement grout 3 Bentonite 4 Other CONCRETE Grout Intervals: From 0 ft. to 3 ft., From 3 ft. to 6 ft., From 17 ft. to 20 ft. What is the nearest source of possible contamination: 1 Septic tank 4 Lateral lines 7 Pit privy 10 Livestock pens 14 Abandoned water well 2 Sewer lines 5 Cess pool 8 Sewage lagoon 11 Fuel storage 15 Oil well/Gas well 3 Watertight sewer lines 6 Seepage pit 9 Feedyard 12 Fertilizer storage 16 Other (specify below)				
Direction from well?					
FROM	TO	LITHOLOGIC LOG	FROM	TO	PLUGGING INTERVALS
0	5.5	CLAY - RED TO BLACK			
5.5	13.0	WEATHERED LIMESTONE			
13.0	20	WEATHERED SHALE - grey			
7 CONTRACTOR'S OR LANDOWNER'S CERTIFICATION:	This water well was (1) constructed, (2) reconstructed, or (3) plugged under my jurisdiction and was completed on (mo/day/year) 10-23-98 and this record is true to the best of my knowledge and belief. Kansas Water Well Contractor's License No. 614 This Water Well Record was completed on (mo/day/year) 11-24-98 by (signature) 				
INSTRUCTIONS: Use typewriter or ball point pen. PLEASE PRESS FIRMLY and PRINT clearly. Please fill in blanks, underline or circle the correct answers. Send top three copies to Kansas Department of Health and Environment, Bureau of Water, Topeka, Kansas 66620-0001. Telephone: 913-296-5545. Send one to WATER WELL OWNER and retain one for your records.					