

1 LOCATION OF WATER WELL:

Fraction

NW $\frac{1}{4}$ NW $\frac{1}{4}$ SE $\frac{1}{4}$

Section Number

3

Township Number

T 26 S

Range Number

R 5 EW

County: BUTLER

Distance and direction from nearest town or city street address of well if located within city?

1631 W. CENTRAL, EC DORADO

2 WATER WELL OWNER: CONOCO INC.


RR#, St. Address, Box #: 600 N. DAIRY Asuford

City, State, ZIP Code: HOUSTON TX, 77079-6651

Board of Agriculture, Division of Water Resources

Application Number:

3 LOCATE WELL'S LOCATION WITH AN "X" IN SECTION BOX:

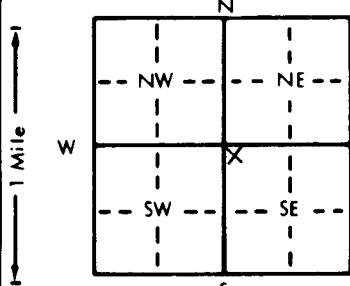

4 DEPTH OF COMPLETED WELL: 16 ft. ELEVATION: 1320.44

Depth(s) Groundwater Encountered 1 ft. 2 ft. 3 ft.

WELL'S STATIC WATER LEVEL: 10.85 ft. below land surface measured on mo/day/yr 10-23-98

Pump test data: Well water was ft. after hours pumping gpm

Est. Yield gpm: Well water was ft. after hours pumping gpm

Bore Hole Diameter: 6.25 in. to 20 ft. and in. to ft.

WELL WATER TO BE USED AS: 5 Public water supply 8 Air conditioning 11 Injection well

1 Domestic 3 Feedlot 6 Oil field water supply 9 Dewatering 12 Other (Specify below)

2 Irrigation 4 Industrial 7 Lawn and garden only 10 Monitoring well 11W-13

Was a chemical/bacteriological sample submitted to Department? Yes No; If yes, mo/day/yr sample was submitted 10-24-98

Water Well Disinfected? Yes No

5 TYPE OF BLANK CASING USED:

1 Steel 3 RMP (SR)

2 PVC 4 ABS

5 Wrought iron

6 Asbestos-Cement

7 Fiberglass

8 Concrete tile

9 Other (specify below)

CASING JOINTS: Glued Clamped

Welded

Threaded

Blank casing diameter 2 in. to 7 ft., Dia in. to ft., Dia in. to ft.

Casing height above land surface 0 in., weight lbs./ft. Wall thickness or gauge No.

TYPE OF SCREEN OR PERFORATION MATERIAL:

1 Steel 3 Stainless steel

2 Brass 4 Galvanized steel

5 Fiberglass

6 Concrete tile

8 RMP (SR)

9 ABS

10 Asbestos-cement

11 Other (specify)

12 None used (open hole)

SCREEN OR PERFORATION OPENINGS ARE:

1 Continuous slot 3 Mill slot

2 Louvered shutter 4 Key punched

5 Gauzed wrapped

6 Wire wrapped

7 Torch cut

8 Saw cut

9 Drilled holes

10 Other (specify)

11 None (open hole)

SCREEN-PERFORATED INTERVALS: From 7 ft. to 16 ft., From ft. to ft. ft. to ft.

From ft. to ft., From ft. to ft. ft. to ft.

GRAVEL PACK INTERVALS: From 6 ft. to 17 ft., From ft. to ft. ft. to ft.

From ft. to ft., From ft. to ft. ft. to ft.

6 GROUT MATERIAL: 1 Neat cement 2 Cement grout 3 Bentonite 4 Other CONCRETE

Grout Intervals: From 0 ft. to 3 ft., From 3 ft. to 6 ft., From 6 ft. to 17 ft., From 17 ft. to 20 ft.

What is the nearest source of possible contamination:

1 Septic tank 4 Lateral lines

2 Sewer lines 5 Cess pool

3 Watertight sewer lines 6 Seepage pit

7 Pit privy

8 Sewage lagoon

9 Feedyard

10 Livestock pens

11 Fuel storage

12 Fertilizer storage

13 Insecticide storage

14 Abandoned water well

15 Oil well/Gas well

16 Other (specify below)

Direction from well?

How many feet?

FROM TO LITHOLOGIC LOG FROM TO PLUGGING INTERVALS

0 11.5 CLAY- grey to red mottled

11.5 13 LIMESTONE

13 20 WEATHERED SHALE - grey

7 CONTRACTOR'S OR LANDOWNER'S CERTIFICATION: This water well was 11 constructed, (2) reconstructed, or (3) plugged under my jurisdiction and was completed on (mo/day/year) 10-23-98 and this record is true to the best of my knowledge and belief. Kansas

Water Well Contractor's License No. 614 This Water Well Record was completed on (mo/day/yr) 11-24-98 by (signature) *W. L. Miller*
under the business name of MAXIM TECH