WATER WELL RECORD Form WWC-5 KSA 82a-1212 ID No. _____ MWH

1 LOCATION OF WATER WELL: County: Butler	Fraction: SE ¼ SE ¼ NW ¼	Section Number: 3	Township Number: T 26 S	Range Number: R 5 (E) W

Distance and direction from nearest town or city street address of well if located within city? 1702 W Central Eldorado, Ks MWH12

2 WATER WELL OWNER: Town & Country
RR#, St. Address, Box # : 1702 W Central
City, State, ZIP Code : Eldorado Ks 67042

Board of Agriculture, Division of Water Resources Application Number:

3 LOCATE WELL'S LOCATION WITH AN "X" IN SECTION BOX:

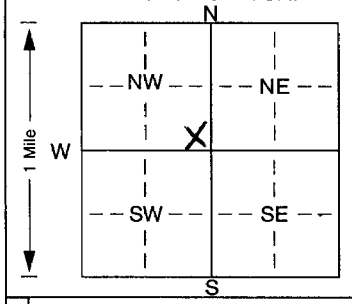

4 DEPTH OF COMPLETED WELL 15 ft. ELEVATION:
Depth(s) Groundwater Encountered 1. ft. 2. ft. 3. ft.
WELL'S STATIC WATER LEVEL ft. below land surface measured on mo/day/yr
Pump test data: Well water was ft. after hours pumping gpm
Est. Yield gpm: Well water was ft. after hours pumping gpm
Bore Hole Diameter 7 1/4 in. to 15 ft., and in. to ft.
WELL WATER TO BE USED AS: 5 Public water supply 8 Air conditioning 11 Injection well
1 Domestic 3 Feedlot 6 Oil field water supply 9 Dewatering 12 Other (Specify below)
2 Irrigation 4 Industrial 7 Domestic (lawn & garden) (10) Monitoring well
Was a chemical/bacteriological sample submitted to Department? Yes. No. —; If yes, mo/day/yrs sample was submitted
Water Well Disinfected? Yes No —

5 TYPE OF BLANK CASING USED: 5 Wrought iron 8 Concrete tile CASING JOINTS: Glued. Clamped.
1 Steel 3 RMP (SR) 6 Asbestos-Cement 9 Other (specify below) Welded
(2) PVC 4 ABS 7 Fiberglass Threaded X
Blank casing diameter 2 in. to 5 ft., Dia in. to ft., Dia in. to ft.
Casing height above land surface 0 in., weight Sched 40 lbs./ft. Wall thickness or gauge No.
TYPE OF SCREEN OR PERFORATION MATERIAL: (7) PVC 10 Asbestos-cement
1 Steel 3 Stainless steel 5 Fiberglass 8 RMP (SR) 11 Other (specify)
2 Brass 4 Galvanized steel 6 Concrete tile 9 ABS 12 None used (open hole)
SCREEN OR PERFORATION OPENINGS ARE: 5 Gauzed wrapped 8 Saw cut 11 None (open hole)
1 Continuous slot (5) Mill slot 0.10 6 Wire wrapped 9 Drilled holes
2 Louvered shutter 4 Key punched 7 Torch cut 10 Other (specify) ft.
SCREEN-PERFORATED INTERVALS: From 15 ft. to 5 ft., From ft. to ft.
From ft. to ft., From ft. to ft.
GRAVEL PACK INTERVALS: From 15 ft. to 3.5 ft., From ft. to ft.
From ft. to ft., From ft. to ft.

6 GROUT MATERIAL: 1 Neat cement (2) Cement grout (3) Bentonite 4 Other
Grout Intervals: From 2 ft. to 3 ft., From 3.5 ft. to 2 ft., From ft. to ft.
What is the nearest source of possible contamination: 10 Livestock pens 14 Abandoned water well
1 Septic tank 4 Lateral lines 7 Pit privy 11 Fuel storage 15 Oil well/Gas well
2 Sewer lines 5 Cess pool 8 Sewage lagoon 12 Fertilizer storage 16 Other (specify below)
(3) Watertight sewer lines 6 Seepage pit 9 Feedyard 13 Insecticide storage
Direction from well? South How many feet? 60'

FROM	TO	LITHOLOGIC LOG	FROM	TO	PLUGGING INTERVALS
0	6"	Gravel & Dark Clay			
6"	2	Top Soil			
2	9	Brn Silty Clay			
9	12	Tan Clayey Limestone			
12	15	Fractured Limestone			
		WLF @ 12' tan			

7 CONTRACTOR'S OR LANDOWNER'S CERTIFICATION: This water well was (1) constructed, (2) reconstructed, or (3) plugged under my jurisdiction and was completed on (mo/day/year) 3-13-01 and this record is true to the best of my knowledge and belief. Kansas Water Well Contractor's Licence No. 575 This Water Well Record was completed on (mo/day/yr) 5-14-01 under the business name of Funkee Drilling Service Inc by (signature) [signature]

INSTRUCTIONS: Use typewriter or ball point pen. *PLEASE PRESS FIRMLY* and *PRINT* clearly. Please fill in blanks, underline or circle the correct answers. Send top three copies to Kansas Department of Health and Environment, Bureau of Water, Topeka, Kansas 66620-0001. Telephone 785-296-5524. Send one to WATER WELL OWNER and retain one for your records. Fee of $5.00 for each constructed well.