

CORRECTION(S) TO WATER WELL RECORD (WWC-5)
(to rectify lacking or incorrect information)

County: Butler

Location listed as:

Section-Township-Range: 26 - 26 S - 5 E

Fraction ($\frac{1}{4}$ $\frac{1}{4}$ $\frac{1}{4}$): SE SE SW

Location changed to:

34 - 25 S - 5 E

SE SE SE

Other changes: Initial statements: _____

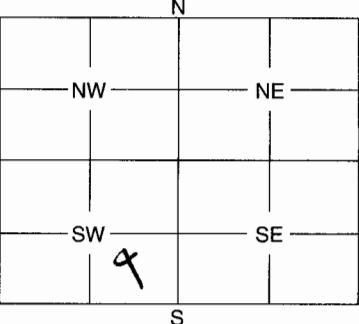
Changed to: _____

Comments: _____

verification method: Written description, city street map, and mapping tool on KGS website.

initials: DR date: 9/17/2009

submitted by: Kansas Geological Survey, Data Resources Library, 1930 Constant Ave., Lawrence, KS 66047-3726
to: Kansas Dept of Health & Environment, Bureau of Water, 1000 SW Jackson, Suite 420, Topeka, KS 6612-1367.

1	LOCATION OF WATER WELL: County: <i>Butler</i>	Fraction <i>SE 1/4 SE 1/4 SW 1/4</i>	Section Number <i>26</i>	Township Number <i>26 S</i>	Range Number <i>5</i>																					
Distance and direction from nearest town or city street address of well if located within city? <i>North of 6th on Topeka in El Dorado KS</i>																										
2	WATER WELL OWNER: RR #, St. Address, Box #: <i>15710 JFK</i> City, State, ZIP Code : <i>Houston TX</i>	Board of Agriculture, Division of Water Resources Application Number:																								
3	MARK WELL'S LOCATION WITH AN "X" IN SECTION BOX: 	4	DEPTH OF WELL <i>32</i> ft.	WELL'S STATIC WATER LEVEL ft.																						
WELL WAS USED AS:																										
<table border="0"> <tr> <td>1 Domestic</td> <td>5 Public Water Supply</td> <td>9 Dewatering</td> </tr> <tr> <td>2 Irrigation</td> <td>6 Oil Field Water Supply</td> <td>10 Monitoring Well</td> </tr> <tr> <td>3 Feedlot</td> <td>7 Domestic (Lawn & Garden)</td> <td>11 Injection Well</td> </tr> <tr> <td>4 Industrial</td> <td>8 Air Conditioning</td> <td>12 Other</td> </tr> </table>						1 Domestic	5 Public Water Supply	9 Dewatering	2 Irrigation	6 Oil Field Water Supply	10 Monitoring Well	3 Feedlot	7 Domestic (Lawn & Garden)	11 Injection Well	4 Industrial	8 Air Conditioning	12 Other									
1 Domestic	5 Public Water Supply	9 Dewatering																								
2 Irrigation	6 Oil Field Water Supply	10 Monitoring Well																								
3 Feedlot	7 Domestic (Lawn & Garden)	11 Injection Well																								
4 Industrial	8 Air Conditioning	12 Other																								
Was a chemical / bacteriological sample submitted to Department? Yes No <i>X</i> If yes, mo/day/yr sample was submitted																										
Water Well Disinfected: Yes No																										
5	TYPE OF BLANK CASING USED:																									
<table border="0"> <tr> <td>1 Steel</td> <td>3 RMP (SR)</td> <td>5 Wrought</td> <td>7 Fiberglass</td> <td>9 Other (Specify below)</td> </tr> <tr> <td><input checked="" type="radio"/> 2 PVC</td> <td>4 ABS</td> <td>6 Asbestos-Cement</td> <td>8 Concrete Tile</td> <td>.....</td> </tr> </table>						1 Steel	3 RMP (SR)	5 Wrought	7 Fiberglass	9 Other (Specify below)	<input checked="" type="radio"/> 2 PVC	4 ABS	6 Asbestos-Cement	8 Concrete Tile											
1 Steel	3 RMP (SR)	5 Wrought	7 Fiberglass	9 Other (Specify below)																						
<input checked="" type="radio"/> 2 PVC	4 ABS	6 Asbestos-Cement	8 Concrete Tile																						
Blank casing diameter <i>4</i> in. Was casing pulled? Yes <i>X</i> No If yes, how much																										
Casing height above or below land surface <i>12</i> in.																										
6	GROUT PLUG MATERIAL: 1 Neat cement 2 Cement grout 3 Bentonite 4 Other																									
Grout Plug Intervals: From ft. to ft., From ft. to ft., From ft. to ft.																										
What is the nearest source of possible contamination:																										
<table border="0"> <tr> <td>1 Septic tank</td> <td>6 Seepage pit</td> <td>11 Fuel storage</td> <td>16 Other (specify below)</td> </tr> <tr> <td>2 Sewer lines</td> <td>7 Pit privy</td> <td>12 Fertilizer storage</td> <td>.....</td> </tr> <tr> <td>3 Watertight sewer lines</td> <td>8 Sewage lagoon</td> <td>13 Insecticide storage</td> <td>.....</td> </tr> <tr> <td>4 Lateral lines</td> <td>9 Feedyard</td> <td>14 Abandoned water well</td> <td>.....</td> </tr> <tr> <td>5 Cess pool</td> <td>10 Livestock pens</td> <td>15 Oil well/Gas well</td> <td>.....</td> </tr> </table>						1 Septic tank	6 Seepage pit	11 Fuel storage	16 Other (specify below)	2 Sewer lines	7 Pit privy	12 Fertilizer storage	3 Watertight sewer lines	8 Sewage lagoon	13 Insecticide storage	4 Lateral lines	9 Feedyard	14 Abandoned water well	5 Cess pool	10 Livestock pens	15 Oil well/Gas well	
1 Septic tank	6 Seepage pit	11 Fuel storage	16 Other (specify below)																							
2 Sewer lines	7 Pit privy	12 Fertilizer storage																							
3 Watertight sewer lines	8 Sewage lagoon	13 Insecticide storage																							
4 Lateral lines	9 Feedyard	14 Abandoned water well																							
5 Cess pool	10 Livestock pens	15 Oil well/Gas well																							
Direction from well? <i>East</i> How many feet? <i>about 1,500 feet</i>																										
<table border="1"> <thead> <tr> <th>FROM</th> <th>TO</th> <th>PLUGGING MATERIALS</th> </tr> </thead> <tbody> <tr> <td><i>32</i></td> <td><i>3</i></td> <td><i>Cement grout</i></td> </tr> <tr> <td><i>3</i></td> <td><i>0</i></td> <td><i>Clay</i></td> </tr> <tr> <td> </td> <td> </td> <td> </td> </tr> </tbody> </table>						FROM	TO	PLUGGING MATERIALS	<i>32</i>	<i>3</i>	<i>Cement grout</i>	<i>3</i>	<i>0</i>	<i>Clay</i>												
FROM	TO	PLUGGING MATERIALS																								
<i>32</i>	<i>3</i>	<i>Cement grout</i>																								
<i>3</i>	<i>0</i>	<i>Clay</i>																								
7	CONTRACTOR'S OR LANDOWNER'S CERTIFICATION: This water well was plugged under my jurisdiction and was completed on (mo/day/year) <i>04/09/04</i> and this record is true to the best of my knowledge and belief. Kansas Water Well Contractor's License No. <i>581</i> . This Water Well Record was completed on (mo/day/year) under the business name of <i>Layne Western</i> by (signature) <i>Steve Walling</i>																									
INSTRUCTIONS: Use typewriter or ball point pen. Please press firmly and print clearly. Please fill in blanks, underline or circle the correct answers. Send top three copies to Kansas Department of Health and Environment, Bureau of Water, Geology Section, 1000 SW Jackson St., Ste. 420, Topeka, Kansas 66612-1367. Telephone: 785/296-5522. Send one to Water Well Owner and retain one for your records.																										