

1 LOCATION OF WATER WELL:

Fraction

Butler

NW $\frac{1}{4}$ NE $\frac{1}{4}$ SE $\frac{1}{4}$ SW $\frac{1}{4}$

Section Number

Township Number

Range Number

County: **Butler**

2

T

26

S

R

5

E

Distance and direction from nearest town or city street address of well if located within city?

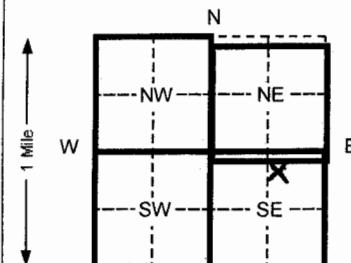
211 E. Central, El Dorado, Kansas

2 WATER WELL OWNER: **Rice Blake Building Attn: Edward Blake**RR#, St. Address, Box # : **401 N. Orchard**

Board of Agriculture, Division of Water Resources

City, State, ZIP Code : **El Dorado, Kansas**

Application Number:

3 LOCATE WELL'S LOCATON WITH
AN "X" IN SECTION BOX:4 DEPTH OF COMPLETED WELL **18.5** ft. ELEVATION:Depth(s) Groundwater Encountered 1 **17.5** ft. 2 ft. 3 ft. **3** Ft.

WELL'S STATIC WATER LEVEL ft. below land surface measured on mo/day/yr

Pump test data: Well water was Ft. after hours pumping Gpm

Est. Yield Gpm: Well water was Ft. after Hours pumping Gpm

Bore Hole Diameter **8.625** in. to **18.5** Ft. and in. to **Ft.**

WELL WATER TO BE USED AS: 5 Public water supply 8 Air conditioning 11 Injection well

1 Domestic 3 Feed lot 6 Oil field water supply 9 Dewatering 12 Other (Specify below)

2 Irrigation 4 Industrial 7 Lawn and garden (domestic) 10 **Monitoring well** **MW-14**Was a chemical/bacteriological sample submitted to Department? Yes **No X** If yes, mo/day/yr sample wasSubmitted Water Well Disinfected? Yes **No X**

5 TYPE OF BLANK CASING USED:

5 Wrought Iron 8 Concrete tile CASING JOINTS: Glued Clamped

1 Steel 3 RMP (SR)

6 Asbestos-Cement 9 Other (specify below)

2 PVC 4 ABS

7 Fiberglass

Welded

X

Blank casing diameter **2** in. to **5** Ft., Dia in. to ft., Dia in. to ft.Casing height above land surface **FLUSH** in., weight **SCH 40** Lbs./ft. Wall thickness or gauge No.

TYPE OF SCREEN OR PERFORATION MATERIAL:

7 **PVC** 10 Asbestos-cement

1 Steel 3 Stainless steel 5 Fiberglass 8 RMP (SR) 11 Other (specify)

2 Brass 4 Galvanized steel 6 Concrete tile 9 ABS 12 None used (open hole)

SCREEN OR PERFORATION OPENINGS ARE: 5 Gauzed wrapped 8 Saw cut 11 None (open hole)

1 Continuous slot 3 Mill slot 6 Wire wrapped 9 Drilled holes

2 Louvered shutter 4 Key punched 7 Torch cut 10 Other (specify)

SCREEN-PERFORATED INTERVALS: From **5** ft. to **18.5** ft. From ft. to ft. From ft. to ft.SAND PACK INTERVALS: From **3** ft. to **18.5** ft. From ft. to ft. From ft. to ft.

From ft. to ft. From ft. to ft. From ft. to ft.

6 GROUT MATERIAL: 1 Neat cement 2 Cement grout 3 Bentonite 4 Other

Grout Intervals From 3 **0** ft. to **1** ft. From 2 **1** ft. to **3** ft. From ft. to ft.

What is the nearest source of possible contamination: 10 Livestock pens 14 Abandoned water well

1 Septic tank 4 Lateral lines 7 Pit privy 11 Fuel storage

2 Sewer lines 5 Cess pool 8 Sewage lagoon 12 Fertilizer storage

3 Watertight sewer lines 6 Seepage pit 9 Feedyard 13 Insecticide storage

15 Oil well/ Gas well

16 Other (specify below)

Contaminated Site

Direction from well? How many feet?

FROM TO CODE LITHOLOGIC LOG FROM TO PLUGGING INTERVALS

0 .75 Asphalt

.75 8 Silty Clay (CL), dark brown

8 18.5 Clayey Silt (ML)

18.5 TD End of Borehole

7 CONTRACTOR'S OR LANDOWNER'S CERTIFICATION: This water well was (x) constructed, (2) reconstructed, or (3) plugged under my jurisdiction and w

Completed on (mo/day/yr) **03/01/05** And this record is true to the best of my knowledge and belief. KansasWater Well Contractor's License No. **585** This Water Well Record was completed on (mo/day/yr) **03/16/05**under the business name of **Associated Environmental, Inc.** By (signature) **Darin R Duncan** **Darin**

INSTRUCTIONS: Please fill in blanks and circle the correct answers. Send three copies to Kansas Department of Health and Environment, Bureau of Water, Topeka, Kansas 66620-0001. Telephone: 913-296-5545. Send one to WATER WELL OWNER and retain one for your records.