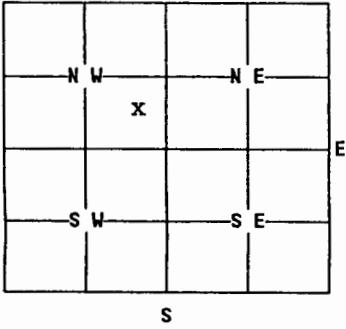


1 LOCATION OF WATER WELL:	Fraction	Section Number	Township Number	Range Number
County: Butler	NE 1/4SE 1/4 NW 1/4	28	26	5

Distance and direction from nearest town or city street address of well if located within city?
2.5 Miles Southwest of El Dorado, Kansas

2 WATER WELL OWNER:	Butler County Landfill RR#, St. Address, Box #: 205 West Central City, State, ZIP Code : El Dorado KS 67042	Board of Agriculture, Division of Water Resources Application Number: na
---------------------	---	---

3 MARK WELL'S LOCATION WITH AN "X" IN SECTION BOX:	N	4 DEPTH OF WELL.....21....ft. 20	WELL'S STATIC WATER LEVEL.....ft.	
		WELL WAS USED AS:		
		1 Domestic 2 Irrigation 3 Feedlot 4 Industrial	5 Public Water Supply 6 Oil Field Water Supply 7 Lawn and Garden Only 8 Air Conditioning	9 Dewatering 10 Monitoring Well 11 Injection Well 12 Other.....
<p>Was a chemical/bacteriological sample submitted to Department? Yes....No. X.... If yes, mo/day/yr sample was submitted.....</p> <p>Water Well Disinfected: Yes...X.. No.....</p>				

5 TYPE OF BLANK CASING USED:	1 Steel 2 PVC	3 RMP (SR) 4 ABS	5 Wrought 6 Asbestos-Cement	7 Fiberglass 8 Concrete Tile	9 Other (specify below)
<p>Blank casing diameter.....8...in. Was casing pulled? Yes.X.... No..... If yes, how much....7!....</p> <p>Casing height above or below land surface.....in.</p>					

6 GROUT PLUG MATERIAL:	1 Neat cement	2 Cement grout	3 Bentonite	4 Other.....
<p>Grout Plug Intervals: From 19...ft. to....7..ft., From.....ft. toft., From..... to.....ft.</p>				

What is the nearest source of possible contamination:					
1 Septic tank 2 Sewer lines 3 Watertight sewer lines 4 Lateral lines 5 Cess Pool	6 Seepage pit 7 Pit privy 8 Sewage lagoon 9 Feedyard 10 Livestock pens	11 Fuel storage 12 Fertilizer storage 13 Insecticide storage 14 Abandoned water well 15 Oil well/Gas well	16 Other (specify below)	Landfill.....	

Direction from well? West..... How many feet? 902!.....					
FROM	TO	PLUGGING MATERIALS			
21'	20'	Sand/Chlorine			
19'	7'	Bentonite			
6'	2'	Clay			
1'	0'	Topsoil			

7 CONTRACTOR'S OR LANDOWNER'S CERTIFICATION: This water well was plugged under my jurisdiction and was completed on (mo/day/year)..... and this record is true to the best of my knowledge and belief. Kansas Water Well Contractor's License No. This Water Well Record was completed on (mo/day/year) January 25, 2006..... under the business name of Butler County Landfill..... by (signature) ..Sandra Koontz.....

Kansas Dept. of Health & Environment
Bureau of Water - Geology Section
1000 SW Jackson Street, Suite 420
Topeka KS 66612-1367

3 Copies to KDHE
1 Copy to Well Owner
1 Copy to Contractor