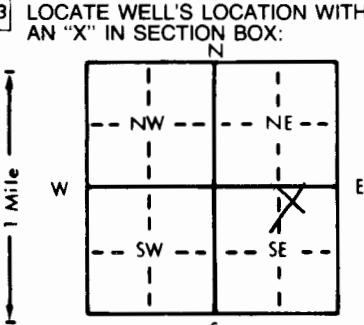


MW-3

1 LOCATION OF WATER WELL: County: <u>Butler</u>		Fraction <u>NW 1/4 NE 1/4 SE 1/4</u>	Section Number <u>2</u>	Township Number <u>T 26 S</u>	Range Number <u>R 5 CW</u>
Distance and direction from nearest town or city street address of well if located within city? <u>211 E. Central</u>					
2 WATER WELL OWNER: RR#, St. Address, Box # : <u>Ed Blake</u> City, State, ZIP Code : <u>401 N. Orchard</u> <u>El Dorado, KS 67042</u>		Board of Agriculture, Division of Water Resources Application Number:			
3 LOCATE WELL'S LOCATION WITH AN "X" IN SECTION BOX: 		4 DEPTH OF COMPLETED WELL <u>15.5</u> ft. ELEVATION: <u>15</u> Depth(s) Groundwater Encountered <u>15</u> ft. 2. <u>—</u> ft. 3. <u>—</u> ft. WELL'S STATIC WATER LEVEL <u>8.94</u> ft. below land surface measured on mo/day/yr Pump test data: Well water was <u>—</u> ft. after <u>—</u> hours pumping <u>—</u> gpm Est. Yield <u>—</u> gpm: Well water was <u>—</u> ft. after <u>—</u> hours pumping <u>—</u> gpm Bore Hole Diameter <u>8.625</u> in. to <u>15.5</u> ft. and <u>—</u> in. to <u>—</u> ft. WELL WATER TO BE USED AS: 5 Public water supply 8 Air conditioning 11 Injection well 1 Domestic 3 Feedlot 6 Oil field water supply 9 Dewatering 12 Other (Specify below) 2 Irrigation 4 Industrial 7 Lawn and garden only 10 Monitoring well <u>MW-3</u> Was a chemical/bacteriological sample submitted to Department? Yes <u>—</u> No <u>X</u> ; If yes, mo/day/yr sample was submitted Water Well Disinfected? Yes <u>—</u> No <u>X</u>			
5 TYPE OF BLANK CASING USED: 1 Steel 3 RMP (SR) <u>2</u> PVC 4 ABS		5 Wrought iron 6 Asbestos-Cement 7 Fiberglass	8 Concrete tile 9 Other (specify below)	CASING JOINTS: Glued <u>—</u> Clamped <u>—</u> Welded <u>—</u> Threaded <u>X</u>	
Blank casing diameter <u>2</u> in. to <u>5.5</u> ft., Dia <u>—</u> in. to <u>—</u> ft., Dia <u>—</u> in. to <u>—</u> ft.		Casing height above land surface <u>0</u> in., weight <u>SCH 40</u> lbs./ft. Wall thickness or gauge No. <u>—</u>			
TYPE OF SCREEN OR PERFORATION MATERIAL: 1 Steel 3 Stainless steel 5 Fiberglass 7 PVC 10 Asbestos-cement 2 Brass 4 Galvanized steel 6 Concrete tile 8 RMP (SR) 11 Other (specify <u>—</u> ) 12 None used (open hole)					
SCREEN OR PERFORATION OPENINGS ARE: 1 Continuous slot <u>3</u> Mill slot 5 Gauzed wrapped 8 Saw cut 11 None (open hole) 2 Louvered shutter 4 Key punched 6 Wire wrapped 9 Drilled holes 7 Torch cut 10 Other (specify <u>—</u> )					
SCREEN-PERFORATED INTERVALS: From <u>5.5</u> ft. to <u>15.5</u> ft., From <u>—</u> ft. to <u>—</u> ft. From <u>—</u> ft. to <u>—</u> ft., From <u>—</u> ft. to <u>—</u> ft. GRAVEL PACK INTERVALS: From <u>4</u> ft. to <u>15.5</u> ft., From <u>—</u> ft. to <u>—</u> ft. From <u>—</u> ft. to <u>—</u> ft., From <u>—</u> ft. to <u>—</u> ft.					
6 GROUT MATERIAL: 1 Neat cement 2 Cement grout 3 Bentonite 4 Other Grout Intervals: <u>2</u> From <u>0</u> ft. to <u>1</u> ft., From <u>1</u> ft. to <u>4</u> ft., From <u>4</u> ft. to <u>—</u> ft. What is the nearest source of possible contamination: 1 Septic tank 4 Lateral lines 7 Pit privy 10 Livestock pens 14 Abandoned water well 2 Sewer lines 5 Cess pool 8 Sewage lagoon 11 Fuel storage 15 Oil well/Gas well 3 Watertight sewer lines 6 Seepage pit 9 Feedyard 12 Fertilizer storage 13 Insecticide storage How many feet? <u>Contaminated site</u>					
Direction from well? FROM TO LITHOLOGIC LOG FROM TO PLUGGING INTERVALS <u>0</u> <u>1</u> <u>Soil w/ some gravel</u> <u>1</u> <u>15.5</u> <u>Clay w/ some silt</u> <u>15.5</u> <u>TD</u> <u>end of borehole</u>					

7 CONTRACTOR'S OR LANDOWNER'S CERTIFICATION: This water well was 1 constructed, (2) reconstructed, or (3) plugged under my jurisdiction and was completed on (mo/day/year) 7/20/98 and this record is true to the best of my knowledge and belief. Kansas Water Well Contractor's License No. 585 This Water Well Record was completed on (mo/day/yr) 7/23/98 by (signature) Alexander J. Deacon  
under the business name of AEI