MW-4

WATER WELL RECORD Form WWC-5 KSA 82a-1212

1 LOCATION OF WATER WELL: County: Butler	Fraction: NW¼ NE¼ SE¼	Section Number: 2	Township Number: T 26 S	Range Number: R 5 (E) W

Distance and direction from nearest town or city street address of well if located within city? 211 E Central

2 WATER WELL OWNER: Edward Blake
RR#, St. Address, Box # : 401 N. orchard
City, State, ZIP Code : El Dorado, KS 67042

Board of Agriculture, Division of Water Resources
Application Number:

3 LOCATE WELL'S LOCATION WITH AN "X" IN SECTION BOX:

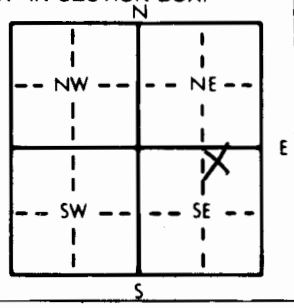

4 DEPTH OF COMPLETED WELL 16.5 ft. ELEVATION:
Depth(s) Groundwater Encountered 1. 14.5 ft. 2. — ft. 3. — ft.
WELL'S STATIC WATER LEVEL 9.65 ft. below land surface measured on mo/day/yr 7/22/98
Pump test data: Well water was — ft. after — hours pumping — gpm
Est. Yield — gpm: Well water was — ft. after — hours pumping — gpm
Bore Hole Diameter 8.625 in. to 16.5 ft., and — in. to — ft.
WELL WATER TO BE USED AS: 5 Public water supply 8 Air conditioning 11 Injection well
1 Domestic 3 Feedlot 6 Oil field water supply 9 Dewatering 12 Other (Specify below)
2 Irrigation 4 Industrial 7 Lawn and garden only (10) Monitoring well MW-4
Was a chemical/bacteriological sample submitted to Department? Yes — No X; If yes, mo/day/yr sample was submitted
Water Well Disinfected? Yes — No X

5 TYPE OF BLANK CASING USED: 5 Wrought iron 8 Concrete tile CASING JOINTS: Glued — Clamped —
1 Steel 3 RMP (SR) 6 Asbestos-Cement 9 Other (specify below) Welded —
(2) PVC 4 ABS 7 Fiberglass Threaded X
Blank casing diameter 2 in. to 6.5 ft., Dia — in. to — ft., Dia — in. to — ft.
Casing height above land surface +2.00 in., weight SCH40 lbs./ft. Wall thickness or gauge No. —

TYPE OF SCREEN OR PERFORATION MATERIAL: (2) PVC 10 Asbestos-cement
1 Steel 3 Stainless steel 5 Fiberglass 8 RMP (SR) 11 Other (specify)
2 Brass 4 Galvanized steel 6 Concrete tile 9 ABS 12 None used (open hole)

SCREEN OR PERFORATION OPENINGS ARE: 5 Gauzed wrapped 8 Saw cut 11 None (open hole)
1 Continuous slot (3) Mill slot 6 Wire wrapped 9 Drilled holes
2 Louvered shutter 4 Key punched 7 Torch cut 10 Other (specify)

SCREEN-PERFORATED INTERVALS: From 6.5 ft. to 16.5 ft., From — ft. to — ft.
From — ft. to — ft., From — ft. to — ft.
SAND GRAVEL PACK INTERVALS: From 5.5 ft. to 16.5 ft., From — ft. to — ft.
From — ft. to — ft., From — ft. to — ft.

6 GROUT MATERIAL: 1 Neat cement (2) Cement grout (3) Bentonite 4 Other —
Grout Intervals: (2) From 0 ft. to 5.5 ft., (3) From 3.5 ft. to 5.5 ft., From — ft. to — ft.

What is the nearest source of possible contamination:
1 Septic tank 4 Lateral lines 7 Pit privy 10 Livestock pens 14 Abandoned water well
2 Sewer lines 5 Cess pool 8 Sewage lagoon 11 Fuel storage 15 Oil well/Gas well
3 Watertight sewer lines 6 Seepage pit 9 Feedyard 12 Fertilizer storage (16) Other (specify below)
13 Insecticide storage contaminated site
Direction from well? How many feet?

FROM	TO	LITHOLOGIC LOG	FROM	TO	PLUGGING INTERVALS
0	1	concrete			
1	16.5	Clay w/some silt			
16.5	TD	end of Borehole			

7 CONTRACTOR'S OR LANDOWNER'S CERTIFICATION: This water well was (1) constructed, (2) reconstructed, or (3) plugged under my jurisdiction and was completed on (mo/day/year) 7/20/98 and this record is true to the best of my knowledge and belief. Kansas Water Well Contractor's License No. 585 This Water Well Record was completed on (mo/day/yr) 7/23/98 under the business name of AEI by (signature) A Duncan for D Duncan

INSTRUCTIONS: Use typewriter or ball point pen. *PLEASE PRESS FIRMLY* and *PRINT* clearly. Please fill in blanks, underline or circle the correct answers. Send top three copies to Kansas Department of Health and Environment, Bureau of Water, Topeka, Kansas 66620-0001. Telephone: 913-296-5545. Send one to WATER WELL OWNER and retain one for your records.