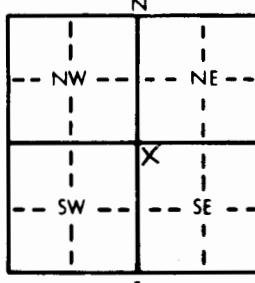
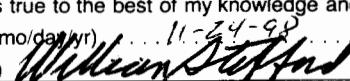


1 LOCATION OF WATER WELL:	Fraction County: BUTLER	Section Number 3	Township Number T 26 S	Range Number R 5 (EW)	
Distance and direction from nearest town or city street address of well if located within city? 1631 W. CENTRAL, EL DORADO					
2 WATER WELL OWNER:	CONOCO INC. RR#, St. Address, Box # : 600 N DAIRY Ashford City, State, ZIP Code : HOUSTON TX, 77079-6651				
Board of Agriculture, Division of Water Resources Application Number:					
3 LOCATE WELL'S LOCATION WITH AN "X" IN SECTION BOX:					
4 DEPTH OF COMPLETED WELL 10 ft. ELEVATION: 1320.50 Depth(s) Groundwater Encountered 1. ft. 2. ft. 3. ft. WELL'S STATIC WATER LEVEL 7.2 ft. below land surface measured on mo/day/yr 10-21-98 Pump test data: Well water was ft. after hours pumping gpm Est. Yield gpm: Well water was ft. after hours pumping gpm Bore Hole Diameter 8.25 in. to 10 ft., and in. to ft. WELL WATER TO BE USED AS: 5 Public water supply 8 Air conditioning 11 Injection well 1 Domestic 3 Feedlot 6 Oil field water supply 9 Dewatering 12 Other (Specify below) 2 Irrigation 4 Industrial 7 Lawn and garden only 10 Monitoring well MW-5 Was a chemical/bacteriological sample submitted to Department? Yes No If yes, mo/day/yr sample was submitted 10-24-98 Water Well Disinfected? Yes No					
5 TYPE OF BLANK CASING USED:	1 Steel 2 PVC	3 RMP (SR) 4 ABS	5 Wrought iron 6 Asbestos-Cement 7 Fiberglass	CASING JOINTS: Glued Clamped Welded Threaded in. to ft., Dia in. to ft., Dia in. to ft.	
Blank casing diameter	2	in. to	5	ft., Dia in. to ft., Dia in. to ft.	
Casing height above land surface	0	in. weight		lbs./ft. Wall thickness or gauge No. 30	
TYPE OF SCREEN OR PERFORATION MATERIAL:	1 Steel 2 Brass	3 Stainless steel 4 Galvanized steel	5 Fiberglass 6 Concrete tile	7 PVC 10 Asbestos-cement 11 Other (specify) 12 None used (open hole)	
SCREEN OR PERFORATION OPENINGS ARE:	1 Continuous slot 2 Louvered shutter	3 Mill slot 4 Key punched	5 Gauzed wrapped 6 Wire wrapped 7 Torch cut	8 Saw cut 9 Drilled holes 10 Other (specify) 11 None (open hole)	
SCREEN-PERFORATED INTERVALS:	From 5 ft.	to 10 ft.	From ft. to ft.		
GRAVEL PACK INTERVALS:	From 4 ft.	to 10 ft.	From ft. to ft.		
6 GROUT MATERIAL:	1 Neat cement Grout Intervals: From 0 ft. to 1 ft.	2 Cement grout From 1 ft. to 4 ft., From 4 ft. to 10 ft.	3 Bentonite 4 Other CONCRETE 10 Livestock pens 11 Fuel storage 12 Fertilizer storage 13 Insecticide storage	14 Abandoned water well 15 Oil well/Gas well 16 Other (specify below)	
What is the nearest source of possible contamination:	1 Septic tank 2 Sewer lines 3 Watertight sewer lines	4 Lateral lines 5 Cess pool 6 Seepage pit	7 Pit privy 8 Sewage lagoon 9 Feedyard	How many feet?	
Direction from well?					
FROM	TO	LITHOLOGIC LOG	FROM	TO	PLUGGING INTERVALS
0	1	FILL			
1	10	CLAY - DK BROWN TO grey Thin LIMESTONE BEDS from 6-10			
10		LIMESTONE			
7 CONTRACTOR'S OR LANDOWNER'S CERTIFICATION:	This water well was 1 constructed, 2 reconstructed, or 3 plugged under my jurisdiction and was completed on (mo/day/year) 10-21-98 and this record is true to the best of my knowledge and belief. Kansas Water Well Contractor's License No. 614 This Water Well Record was completed on (mo/day/year) 11-24-98 by (signature) 				

INSTRUCTIONS: Use typewriter or ball point pen. PLEASE PRESS FIRMLY and PRINT clearly. Please fill in blanks, underline or circle the correct answers. Send top three copies to Kansas Department of Health and Environment, Bureau of Water, Topeka, Kansas 66620-0001. Telephone: 913-296-5545. Send one to WATER WELL OWNER and retain one for your records.