

## WATER WELL PLUGGING RECORD

Form WWC-5P

KSA 82a-1212

ID No.

MW-10

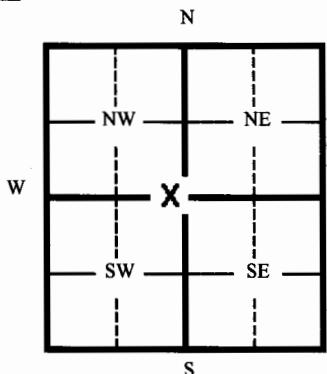
1 LOCATION OF WATER WELL:		Fraction	Section Number	Township Number	Range Number
County:	Butler	SE 1/4 SE 1/4 NW 1/4	3	26	5-East

Distance and direction from nearest town or city street address of well if located within city?

1701 W. Central Street, El Dorado, Kansas

2 WATER WELL OWNER: **Town & Country Markets**RR#, St. Address, Box # **P.O. Box 17087**City, State, ZIP Code : **Wichita, Kansas 67217**Board of Agriculture, Division of Water Resources  
Application Number:

3 MARK WELL'S LOCATON WITH AN "X" IN SECTION BOX:

4 DEPTH OF WELL **15.0** ft.WELL'S STATIC WATER LEVEL **5.85** ft.

WELL WAS USED AS:

1 Domestic	5 Public Water Supply
2 Irrigation	6 Oil Field Water Supply
3 Feedlot	7 Lawn and Garden (domestic)
4 Industrial	8 Air Conditioning

9 Dewatering
10 Monitoring Well
11 Injection Well
12 Other

Was a chemical/bacteriological sample submitted to Department?

Yes  No 

If yes, mo/day/yr sample was submitted

Water Well Disinfected: Yes  No 

5 TYPE OF BLANK CASING USED:

1 Steel 3 RMP (SR) 5 Wrought 7 Fiberglass 9 Other (specify below)

2 PVC 4 ABC 6 Asbestos-Cement 8 Concrete Tile

Blank casing diameter **2.375** in. Was casing pulled? Yes  No  If yes, how much? **15.0'**Casing height above or below land surface **Unknown** in.**Overdrilled well to 15.0'**6 GROUT PLUG MATERIAL: 1 Neat cement 2 Cement grout 3 Bentonite 4 Other **Soils**Grout Plug Intervals From **15.0** ft. to **3.0** ft. From **3.0** ft. to **0.0** ft. From **0.0** ft. to **0.0** ft.

What is the nearest source of possible contamination:

1 Septic tank	6 Seepage pit	11 Fuel storage (former)	16 Other (specify below)
2 Sewer lines	7 Pit privy	12 Fertilizer storage	
3 Watertight sewer lines	8 Sewage lagoon	13 Insecticide storage	
4 Lateral lines	9 Feedyard	14 Abandoned water well	
5 Cess Pool	10 Livestock pens	15 Oil well/ Gas well	

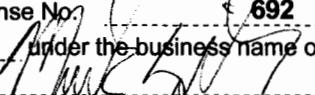
Direction from well? **North** How many feet? **420**

FROM	TO	CODE	PLUGGING MATERIALS
<b>0.0</b>	<b>3.0</b>		<b>Compacted soils</b>
<b>3.0</b>	<b>15.0</b>		<b>Bentonite chips</b>

7 CONTRACTOR'S OR LANDOWNER'S CERTIFICATION: This water well was plugged under my jurisdiction and was completed on (mo/day/yr) **10/17/06** and this record is true to the best of my knowledge and belief. KansasWater Well Contractor's License No: **692** This Water Well Record was completed on (mo/day/yr)

10/30/06 under the business name of

Quad State Services, Inc.

by (signature) 

INSTRUCTIONS: Please fill in blanks and circle the correct answers. Send three copies to Kansas Department of Health and Environment, Bureau of Water, 1000 S W Jackson St., Ste. 420, Topeka, Kansas 66620-0001. Telephone: 785-296-3565. Send one to Water Well Owner and retain one for your records.